

WATER SERVICE RECORD

Name William J. Daly

Service No. 22

Address 48 Grapevine Avenue

# 3690

Location Lot #37

~~Renewal~~ New Service Valeri Const. Permit #A284

Comm 23, 1966


Date		Material	Amount	Total	Date		Amount
5/14/66	42'	3/4" Copper tubing			5-9-66	Deposit	23.82
						CURB TO MAIN	
					1957	32' 3/4" Copper tubing	8.62
						1 3/4" Corp Cock	4.64
						1 3/4" Curb Cock	5.94
						1 Box & Rod	4.62
							23.82
						installed by contractor	

DATE \_\_\_\_\_

# TOWN OF LEXINGTON — BOARD OF PUBLIC WORKS

## WATER DIVISION

Sketch of Service Here

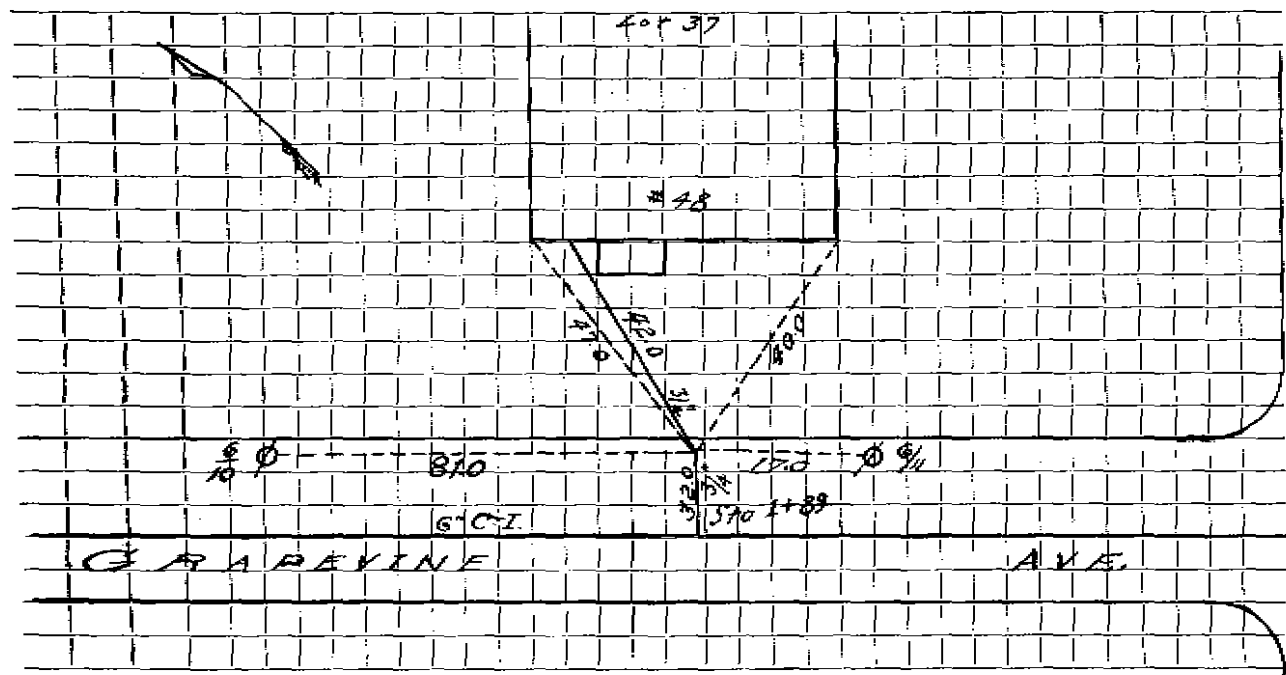

Connection made in ..... Street. Work completed .....

Remarks: .....

.....

.....