

#4703

**WATER SERVICE RECORD**

Name Mary Louise Perkins

Service No. 1

Address 56 Grapevine Ave.

Location

~~Repair~~ ~~Renewal~~ ~~New Service~~ #7858


**FEB 3 1969**

| Date   | Material             | Amount | Total  | Date   | Amount         |
|--------|----------------------|--------|--------|--------|----------------|
| 1/8/69 | Labor                | 44.84  |        | 1-2-69 | Deposit 125.00 |
|        | 10% O.H.             | 4.48   | 49.32  | 2-3-69 | Retrad 23.26   |
| 28     | 3/4" Copper pipe .79 |        | 22.12  |        | 101.74         |
| 1      | 3/4" Wheel Valve     |        | 9.30   | 5/1/57 | 3/4 COPPER     |
| 1      | Hr. Trucking         |        | 3.00   | 1      | 3/4 Curb       |
| 2      | " Shovel 6.50        |        | 13.00  |        |                |
| 1      | " Compressor         |        | 5.00   |        | Born + Rod     |
|        |                      |        | 101.74 |        |                |

DATE \_\_\_\_\_

**TOWN OF LEXINGTON — BOARD OF PUBLIC WORKS**  
**WATER DIVISION**

Sketch of Service Here

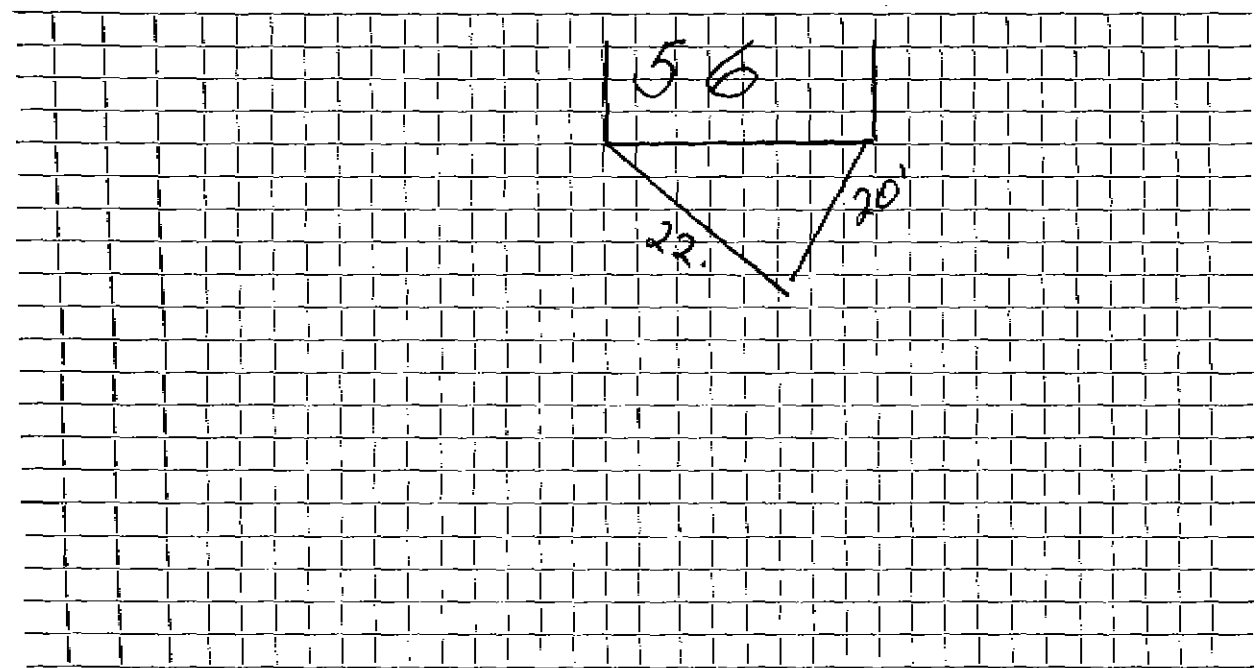

Connection made in ..... Street. Work completed .....

Remarks: .....  
.....  
.....