WATER SERVICE RECORD

Service No.

Name

Address

Bill DeBonte


Location Repair—Renewal—New Service Ed Banks #0005							
9/12/89	27'	3/4" Copper					
	· 			 	<u> </u>		
	<u> </u>	- 	<u> </u>	, ; 	 		
-	 			ļ	- <u>"</u>		
<u> </u>	 			 - - 	 		
_	 -			ļ —————	· · · · · · · · · · · · · · · · · · ·		
	!		-		-# +		
_			- - 				
	·		- 				
	<u> </u>						
	<u>.</u>	<u> </u>	·	 	 		
- -	!		<u> </u>	ļ	<u> </u>	·- 	
	4	- 	- 	'	 		
		·		ļ <u>-</u>	"		
	<u> </u>			 			
		· _ 		; : - :	 		
_ _	!! i _ i				- +		

DATE 9/12/89

TOWN OF LEXINGTON - BOARD OF PUBLIC WORKS

WATER DIVISION

Sketch of Service Here

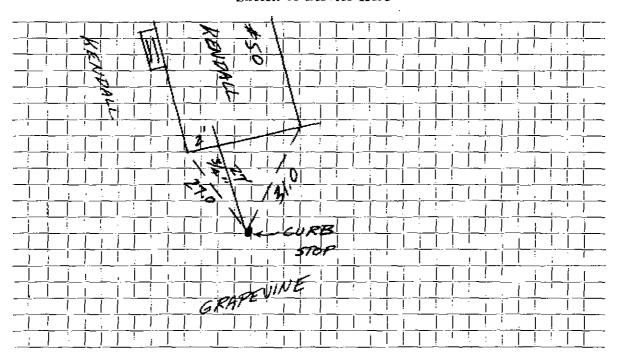

Connection made in	Work completed
Remarks: INSP. CRG	
