




DATE \_\_\_\_\_

TOWN OF LEXINGTON — BOARD OF PUBLIC WORKS

WATER DIVISION

Sketch of Service Here

W.S. For Lot 40

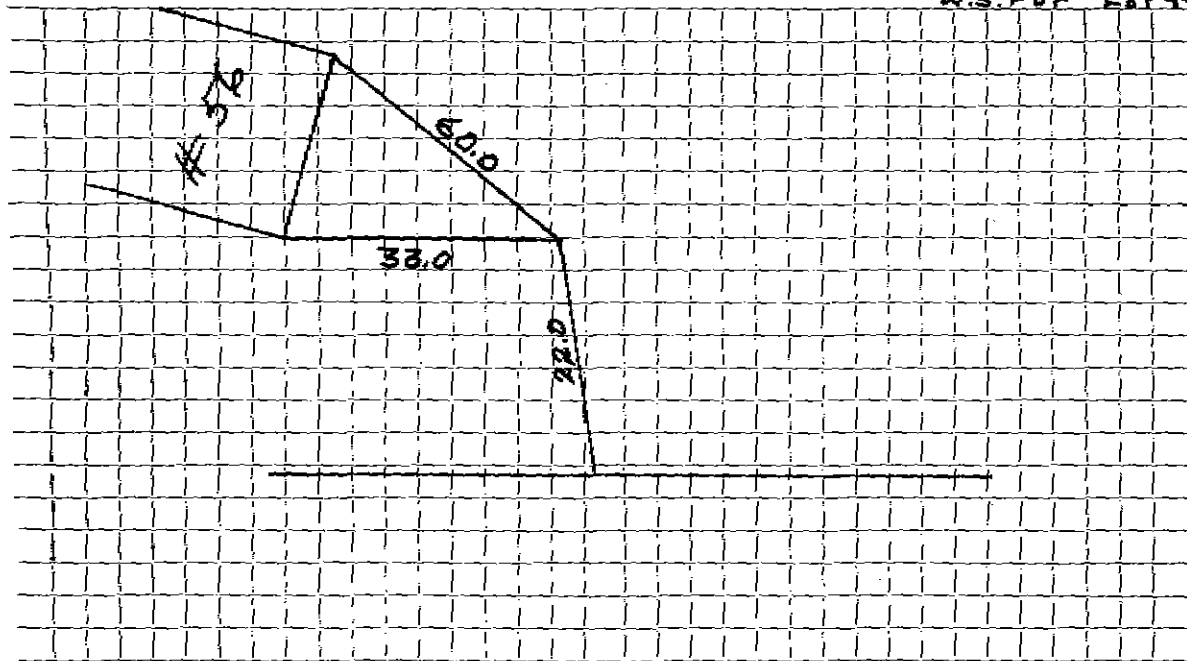

Connection made in ..... Street. Work completed .....

Remarks: .....

.....  
.....