


DATE 8/1/2019

TOWN OF LEXINGTON — BOARD OF PUBLIC WORKS

WATER DIVISION

Sketch of Service Here

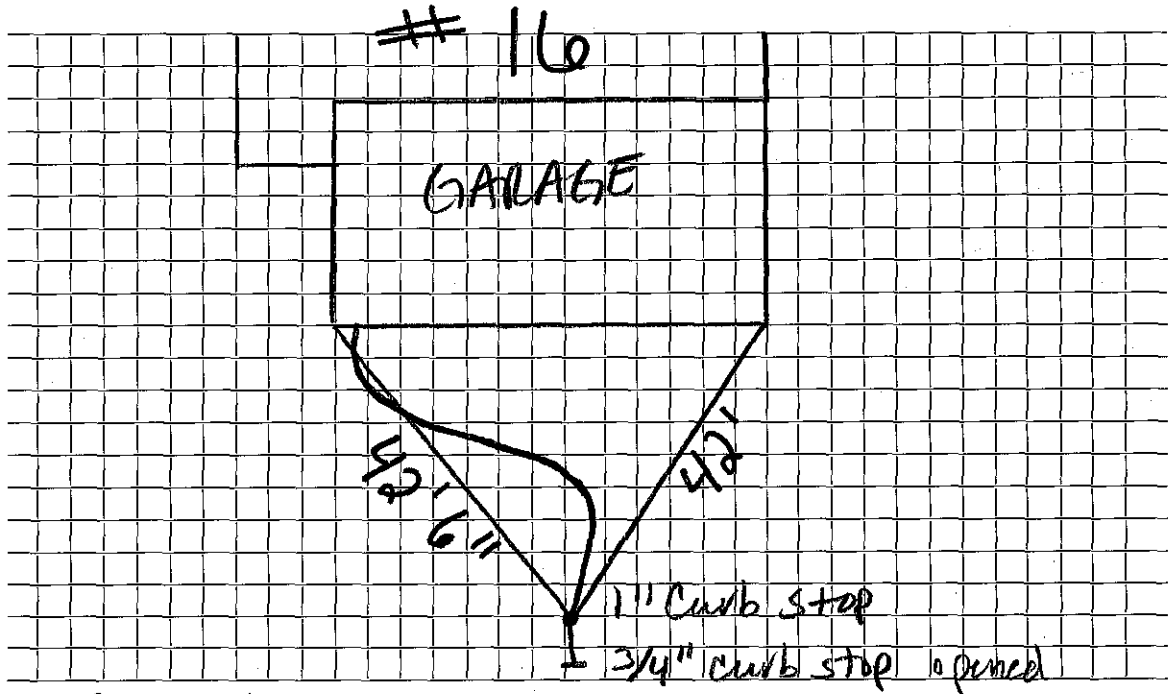

Connection made in..... Grapevine..... Street. Work completed

Remarks:.....
.....
.....