

WATER SERVICE RECORD

Name Sara B. Chase

Service No. 32

Address 1 Grassland St.

Location


~~Repair~~ - Renewal - ~~New Service~~ WO #4618

Date	Material	Amount	Total	Date	Amount	
6/24/76	labor	52. 82		6/22/76	Deposit	250. 00
	10%OH	5. 28	58. 10	7/16/76	Refund	148. 38
28'	6" copper @ .65		18. 20			101. 62
1	3/4" wheel handle		14. 53	1/11/55	20' 3/4 COPPER	
2	yds. loam @ 4.50		9. 00	1	3/4 CORP ADAPTER	
2	lbs. grass seed @ .39		. 78	1	3/4 Curb Cock	
	Fertilizer		1. 00		Box + Rod	
			101. 62			

DATE _____

TOWN OF LEXINGTON — BOARD OF PUBLIC WORKS
WATER DIVISION

Sketch of Service Here

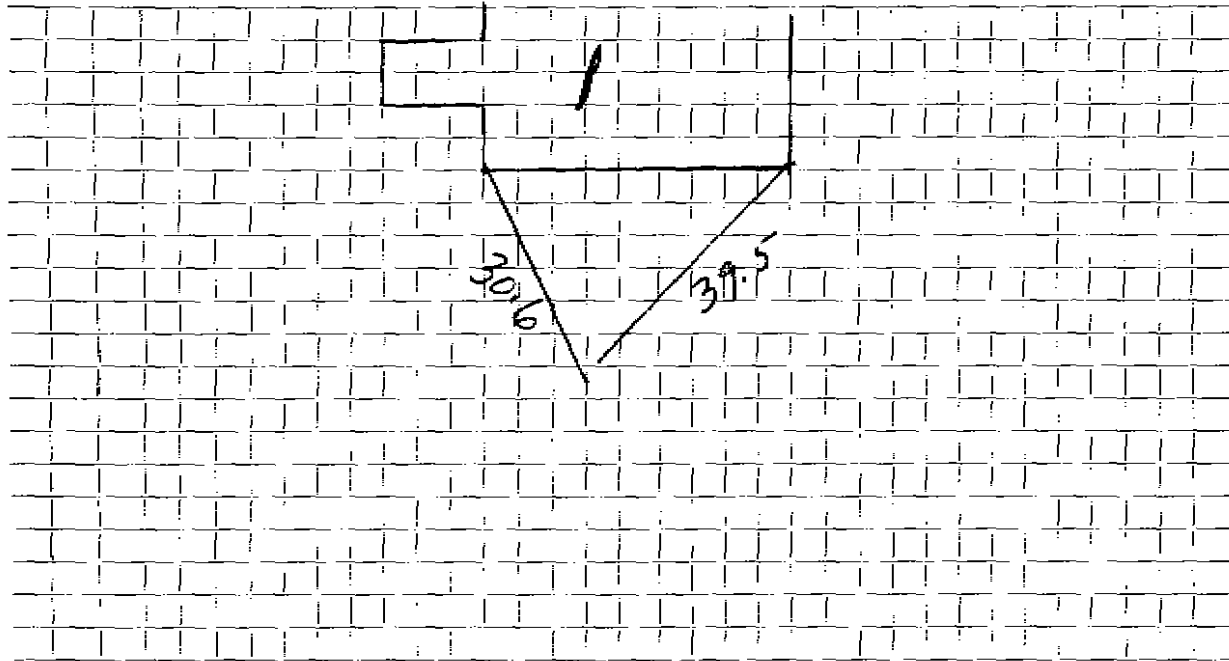

Connection made in Street. Work completed

Remarks:
.....
.....

WATER SERVICE RECORD

Name

Service No.

Address 1 GRASSLAND STREET

Location 8" MAIN ON GRASSLAND ST; BEFORE REDUCING TO 6" MAIN


Repair ~~Renewal~~ New Service WATER MAIN CLEANING & LINING PROJECT C99-02 ; BISKKO Co.

Date	Material	Amount	Total	Date	Amount
				7-8-1999	
				2'	COPPER BTW NEW CORP & EXISTING BOX UNION
				1	CORPORATION
				1	UNION

DATE 7-8-1999

TOWN OF LEXINGTON — BOARD OF PUBLIC WORKS
WATER DIVISION

Sketch of Service Here

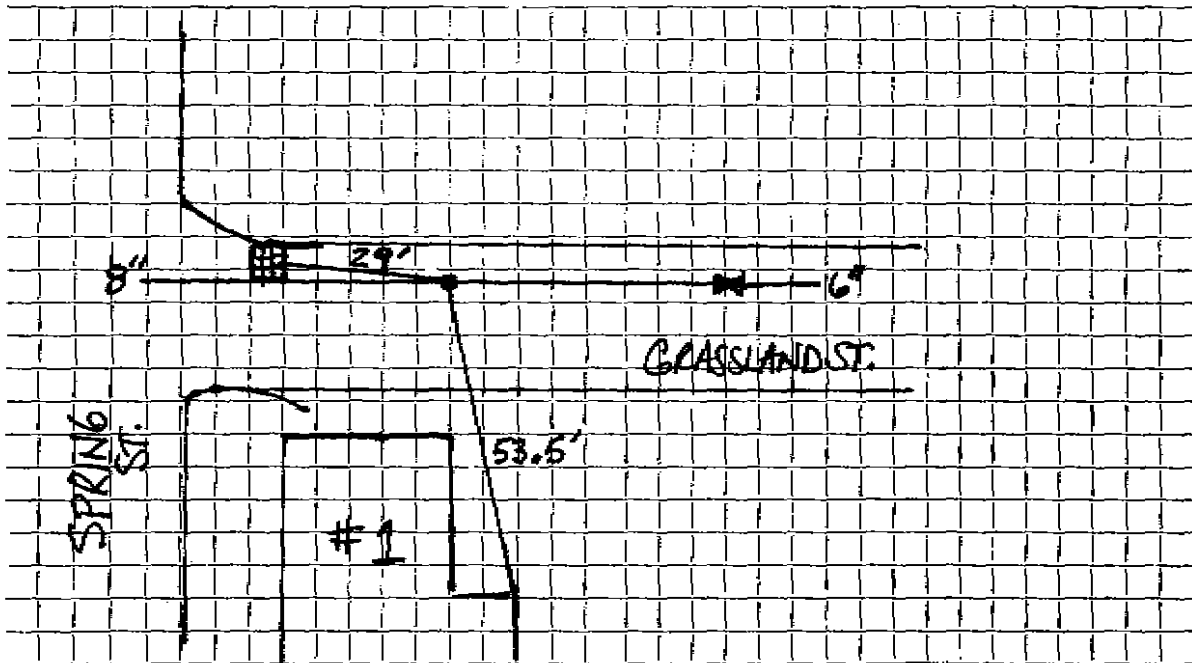

Connection made in 8" MAIN PORTION of GRASSLAND Street.

Work completed NEW COOPERATION, UNION

Remarks: COOPERATION ONLY