

pd. by:

Name John Kennedy

Owner: C.H. MacAuley

Service No. ~~100~~ 1091

Address 30 Brook St., Brookline, Mass.

#3339

Location 10 Grassland St.,

Kind of Pipe

Size

Size of Main

Repair—Renewal—New Service

Location

Date 1941	Material	Amount	Total	Date	Amount
Sept. 19	2 hrs. @ 60¢	1 20		Sept. 12, 1941	17 00
Com 10/13/41	10% Overhead	12	1 32	Oct 21, 1941	446
	38' 3/4" Copper tubing	19¢	7 22		12 34
	1 3/4" C.S.& W.		2 50	W.O.#7155	NON-CHARGE-Extended water service
	Trucking, 2 hrs. @ 75¢		1 50	8/8/68	Labor 24 17
			12 54	1	3/4" Curb Cock 11 32
					Box & Rod 5 10
				1	hr. Trucking 3 00
				3	" Hired shovel @ 12.00 36 00
					79 59

Labor

*Deposited*  
*Refused*

Hadley Press, Inc., Lexington

DATE \_\_\_\_\_

# TOWN OF LEXINGTON—BOARD OF PUBLIC WORKS

## WATER DIVISION

The undersigned applies for a supply of water at No. 10 Greenland St. and hereby agrees to comply with the rules and regulations as now, or at any future time, established by the Board of Selectmen.

Am't. of Estimate \$ \_\_\_\_\_

Owner E. H. Mac. Auley


Am't. Paid \$ \_\_\_\_\_

Address 30 Brook St

Builder John Kennedy

Brookline, Mass.

Sketch of Service Here

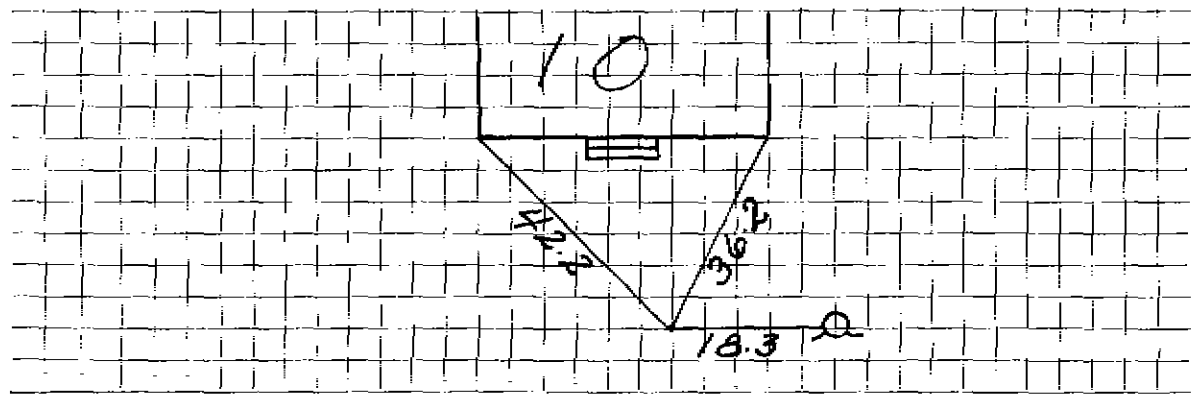

Connection made in \_\_\_\_\_ Street.

Work completed \_\_\_\_\_ 19

Remarks: