

Name Lexington Co-op. Bank

Service No. # 1092

Address 1778 Mass. Avenue, Lexington

Locatic // Grassland St.

Kind of Pipe

Size

Size of Main

~~Repair~~ ~~Renewal~~ New Service

Location

Date	Material	Amount	Total	Date	Amount
April 20	55 hrs. @ 55¢	28 60		<i>June 24, 1935 - Cash</i>	46 63
<i>Don't Recall</i>	2 " @ 60¢	1 20	29 80		
<i>6-18-35 - 2-16-35</i>	10% Overhead-labor		2 98		
	43' 1" C.L. Pipe @ 20¢		8 60		
	3 1" L.L. Coup. 25¢		75		
	2 1" L.L. Ells 30¢		60		
	2 1" Brass Nipples 20¢		40		
	1 S. & W.		2 75		
	Trucking		75		
			<u>46 63</u>		
	Labor				

Hadley Press, Inc., Lexington

DATE _____

TOWN OF LEXINGTON—BOARD OF PUBLIC WORKS

WATER DIVISION

The undersigned applies for a supply of water at No. Grassland St. and hereby agrees to comply with the rules and regulations as now, or at any future time, established by the Board of Selectmen.

Am't. of Estimate \$ _____


Owner Lexington Co-operative Bank

Am't. Paid \$ _____

Address by W.H. Coultter,
177 Main Ave Lexington

Builder _____

Sketch of Service Here

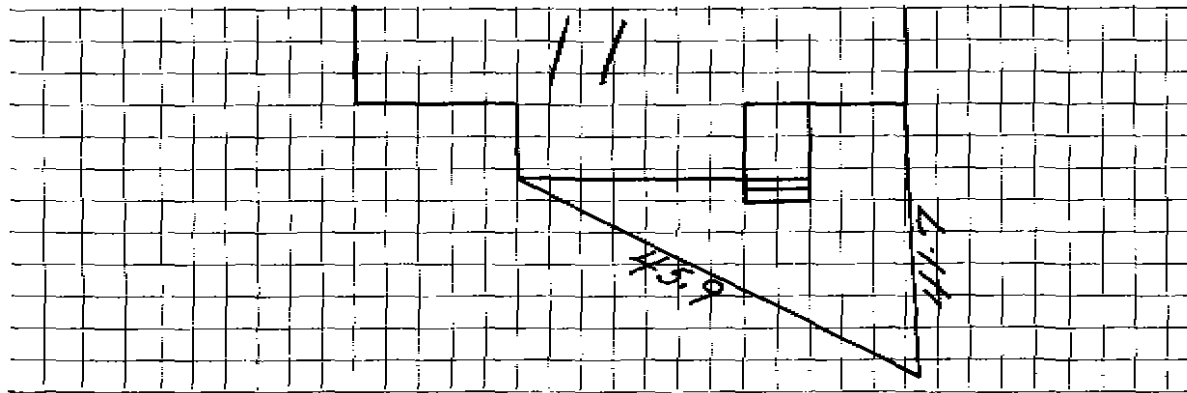

Connection made in _____ Street. Work completed _____ 19

Remarks: