

4872

WATER SERVICE RECORD

Name Donna Realty Trust

Service No. 44

Address 13 Grassland St.

Location

Repair-Renewal-New Service W.O.#7194 Valeri #1156


NOV 18 1968

Date		Material	Amount		Total		Date	Amount
8/13/68		Labor	12	45			8-13-68	230 00
8/14/68		"	41	84			11-18-68	71 23
		10% O.H.	5	43	59	72		148 97
		44'-3/4" copperpipe			34	76		
	1	3/4" curb cock			11	32		
	1	3/4" corporation			9	57		
	1	Box & rod			5	10		
	3	Hrs. shovel @ 6.50			19	50		
	3	" trucking @ 3.00			9	00		
					148	97		
8-20-68	30'	3/4" Copper tubing						

DATE _____

TOWN OF LEXINGTON — BOARD OF PUBLIC WORKS
WATER DIVISION

Sketch of Service Here

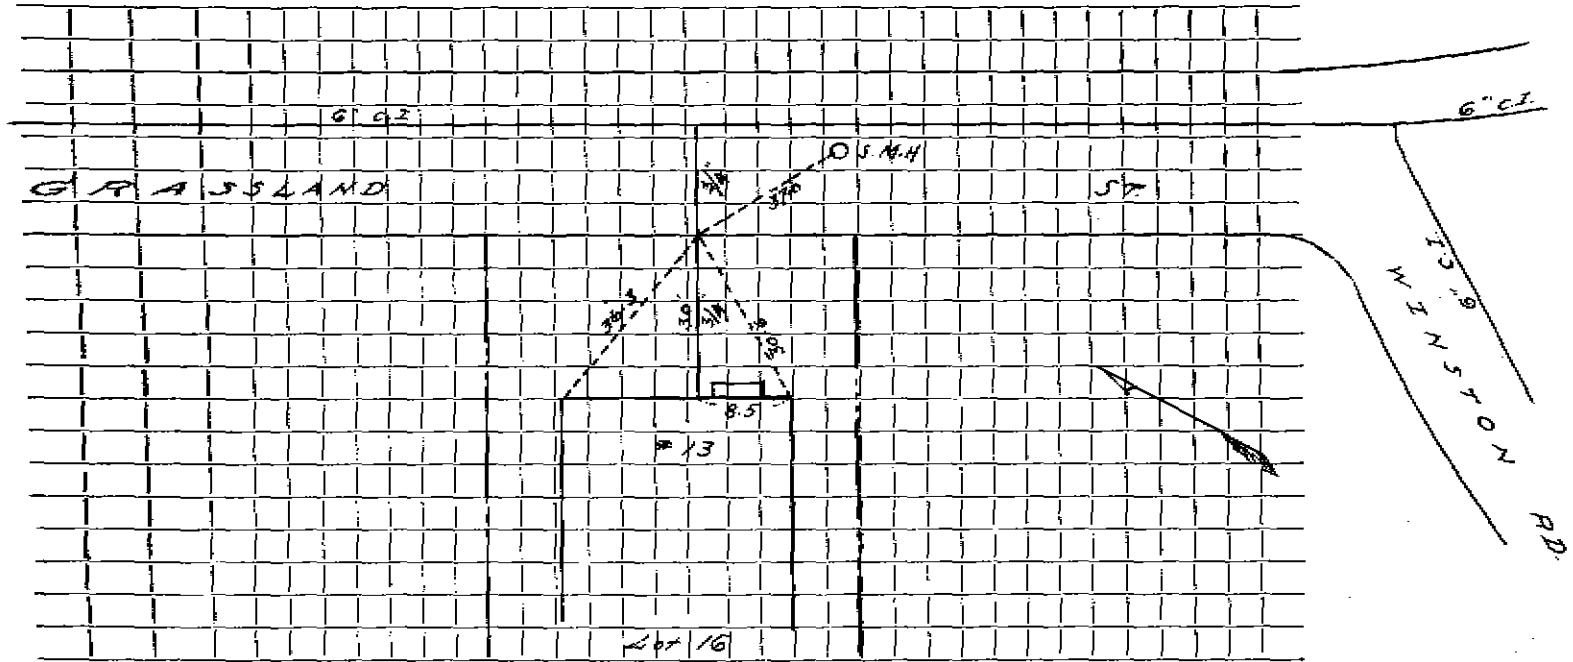

Connection made in Street. Work completed

Remarks:

.....

.....