


DATE 6/9/88

TOWN OF LEXINGTON — BOARD OF PUBLIC WORKS

WATER DIVISION

Sketch of Service Here

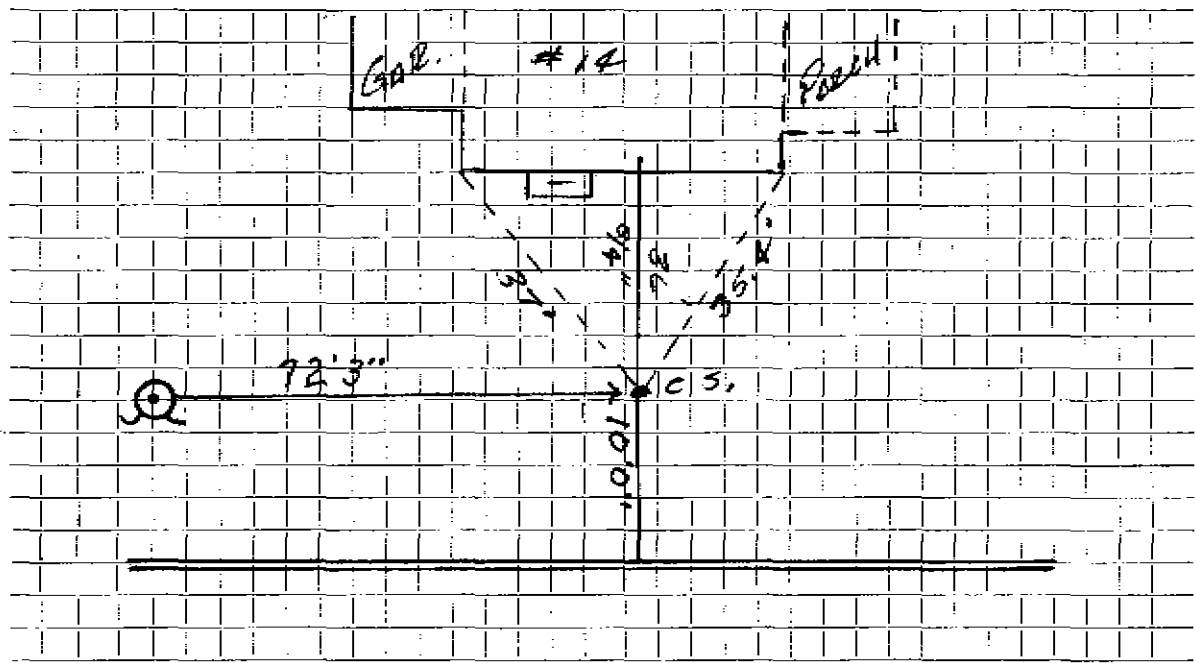

Connection made in GRASSLAND..... Street. Work completed

Remarks: CURB STOP CLOSE TO GAS MAIN.....

.....

.....