

Name MacLand Incorporated

Service No. 258

Address 17 Grassland Street

Lexington, Mass.

Location 17 Grassland Street

Kind of Pipe

Size

Size of Main

~~Rep. of Existing~~ - New Service

Com. 11-6-50

Location

Date	Material	Amount	Total	Date	Amount	
Sept. 6, '50	Labor	1 50	1 50		10 00	
	10% Overhead		15		2 07	
	55' - 3/4" Copper Tubing @.275		15 13		22 07	
	1 - 3/4" C x 1/2" I.W.H. S&W		3 15	Sept. 6, '50	Labor	4 00
	1 - 3/4" C x 3/4" C Union (3pts)		1 39	24'	- 3/4" Copper Tubing @.275	6 60
	Trucking 1 hr. @.75		75	1 - 3/4" C Corp-cock		3 15
			22 07	1 - 3/4" C x 3/4" C Curb-cock		3 85
				1 - Box & Rod		3 35
				1 - 1/2" Offset Tail Piece		42
				1 - 1/2" Straight Tail Piece		42
				Trucking 1 hr. @.75		75
						22 54
10-5	66 Broken by contractor			8-6-86	LOWERED APPROXIMATELY	
	8 3/4" Copper				1" & INSULATED	
	1 3 pt union					
	Labor					

Madley Press, Inc., Lexington

DATE _____

TOWN OF LEXINGTON—BOARD OF PUBLIC WORKS

WATER DIVISION

The undersigned applies for a supply of water at No. _____ St. and hereby agrees to comply with the rules and regulations as now, or at any future time, established by the Board of Selectmen.

Am't. of Estimate \$ _____


Owner _____

Am't. Paid \$ _____

Address _____

Builder _____

Sketch of Service Here

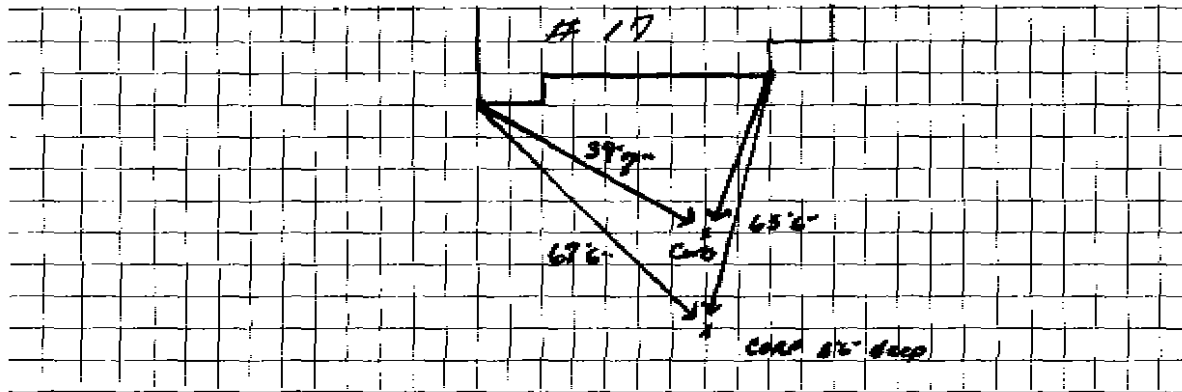

Connection made in _____ Street.

Work completed _____ 19

Remarks: