

Name John Kennedy  
 Address 20 Grassland Street  
 Lexington, Mass.

Service No. 21<sup>L</sup>  
 3113

Location 20 Grassland Street

Kind of Pipe Size Size of Main  
~~Repair~~ ~~Renewal~~ — New Service Com. 11-6-50 Location

Date	Material	Amount	Total	Date	Amount
Aug. 21 '50	Labor	5 00	5 00	Aug 9 '50	00 00
	10% Overhead		50		
	36' - 3/4" Copper Tubing	8.275	9 90		
	1 - 3/4" C x 1/2" I.W.F. S&W		3 29		
	Brox Shovel 1 hr. @ 9.00		9 00	aug. 21, '50	5 20
	Trucking 1 hr. @ .75		75	11' - 3/4" Copper Tubing	3 03
			<u>23 44</u>	1 - 3/4" C Corp-cock	3 15
				1 - 3/4" C x 3/4" C Curb-cock	3 85
				1 - Box & Rod	3 35
				1 - 1/2" Offset Tail Piece	42
				1 - 1/2" Straight Tail Piece	42
				Trucking 1 hr. @ .75	75
					<u>20 17</u>
	Labor			8-4 - 86	lowered
				116	3/4" COPPER
				1	3/4" PLOG
					INSTALLATION
				1	3/4" COP

Hadley Press, Inc., Lexington

DATE \_\_\_\_\_

# TOWN OF LEXINGTON - BOARD OF PUBLIC WORKS

## WATER DIVISION

The undersigned applies for a supply of water at No. \_\_\_\_\_ St. and hereby agrees to comply with the rules and regulations as now, or at any future time, established by the Board of Selectmen.

Am't. of Estimate \$ \_\_\_\_\_


Owner \_\_\_\_\_

Am't. Paid \$ \_\_\_\_\_

Address \_\_\_\_\_

Builder \_\_\_\_\_

Sketch of Service Here

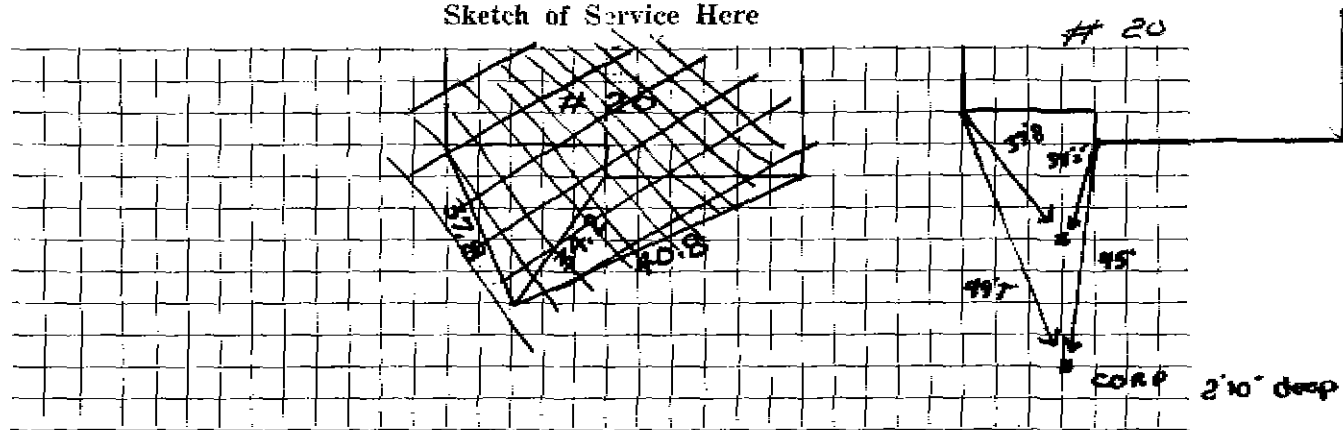

Connection made in \_\_\_\_\_ Street.

Work completed \_\_\_\_\_ 19\_\_

Remarks: