

WATER SERVICE RECORD

Name

Service No.

Address

24 Grassland St.

Location

Repair—Renewal—New Service

(Extended Water service) W.O.#7166


Date	Material	Amount	Total	Date	Amount
	<u>NON-CHARGE</u>				
8/8/68	Labor	24 17		12/18/53	
1	3/4" Curb Cock	11 32		10' 10'	3/4 COPPER
1	Hr. Trucking	3 00		1	3/4 CORP
3	" Hired shovel	36 00		1	3/4 Curb
		74 49			Box Rod
12/18/53	55" 3/4 COPPER				
1	3/4x 1/2 STLW				

DATE _____

TOWN OF LEXINGTON — BOARD OF PUBLIC WORKS

WATER DIVISION

Sketch of Service Here

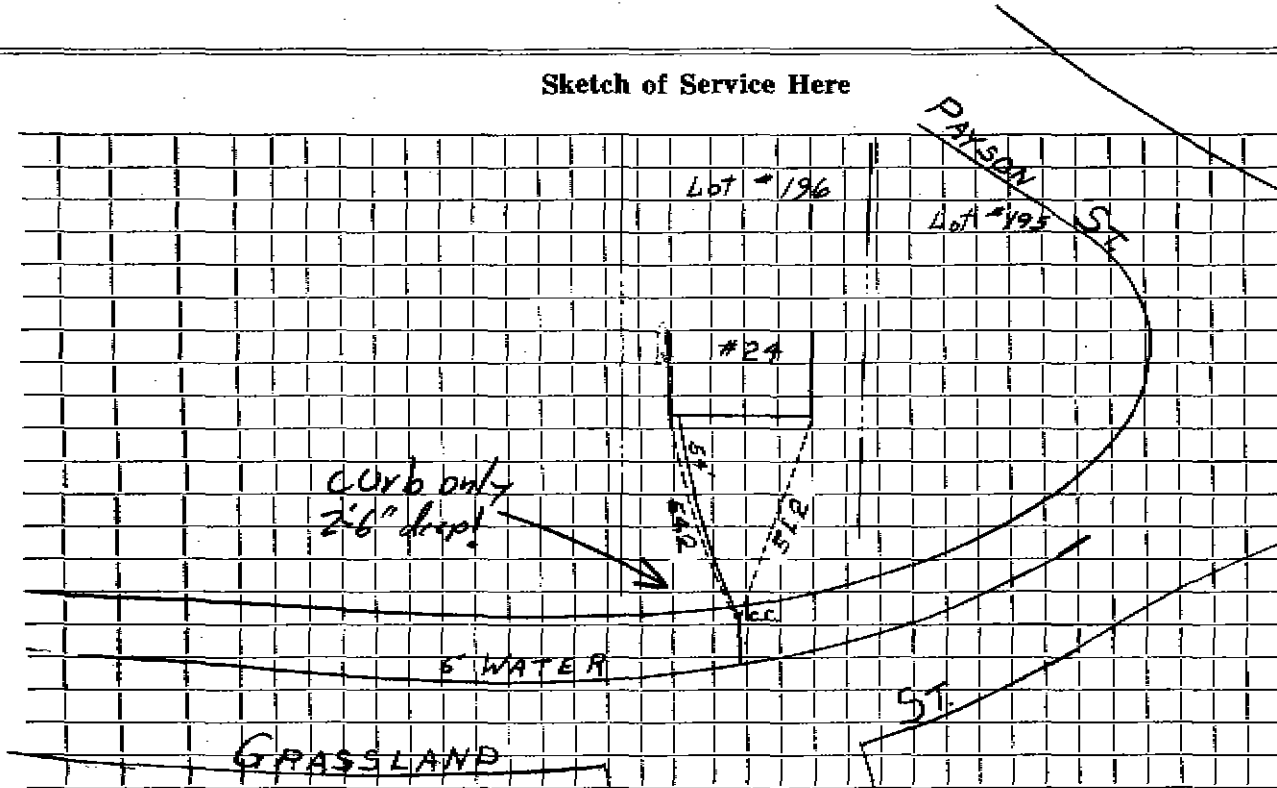

Connection made in Street. Work completed

Remarks: water service is only 2 1/2 feet deep st. curb. (town has been lowered by owner.)