

WATER SERVICE RECORD

Name *MacLand Inc..*

Service No.

Address *27 Grassland Street*

Location


~~Repair - Renewal~~ **New Service**

Date	Material	Amount	Total	Date	Amount
<i>9/07/50</i>	<i>Labor</i>	<i>1.50</i>			
	<i>10 % O.H.</i>	<i>15</i>	<i>1.65</i>		
<i>50'</i>	<i>3/4" Copper tubing @.275</i>		<i>13.75</i>		
<i>1</i>	<i>3/4"C x 1/2" I.W.H. S & W</i>		<i>3.29</i>		<i>OUTSIDE</i>
<i>1</i>	<i>hr. Trucking</i>		<i>.75</i>	<i>9/07/50</i>	<i>Labor</i> <i>4.30</i>
			<i>\$19.44</i>		<i>32' 3/4" Copper tubing @.275</i> <i>8.80</i>
					<i>1 3/4" Corp-cock</i> <i>3.15</i>
					<i>1 3/4"C x 3/4"C Curb Cock</i> <i>3.85</i>
					<i>1 Box & Rod</i> <i>3.35</i>
					<i>1 1/2" Offset Tailpiece</i> <i>.42</i>
					<i>1 1/2" Straight Tailpiece</i> <i>.42</i>
					<i>1 hr. Trucking</i> <i>.75</i>
					<u><i>25.04</i></u>

DATE _____

TOWN OF LEXINGTON — BOARD OF PUBLIC WORKS
WATER DIVISION

Sketch of Service Here

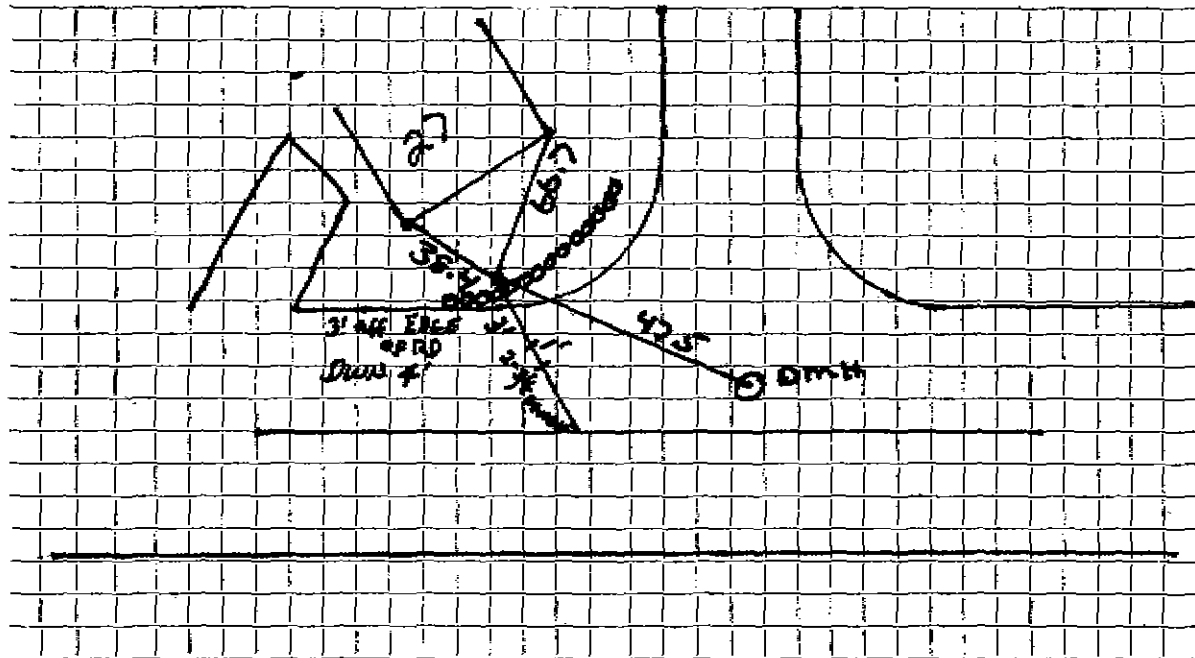

Connection made in Street. Work completed

Remarks: *Heath Drilled Through Copper Gas Co. 10/97*