
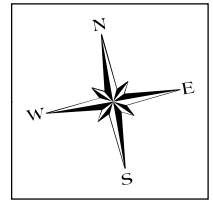


Water Service Tie Card
TOWN OF LEXINGTON
 MASSACHUSETTS

30 Grassland St

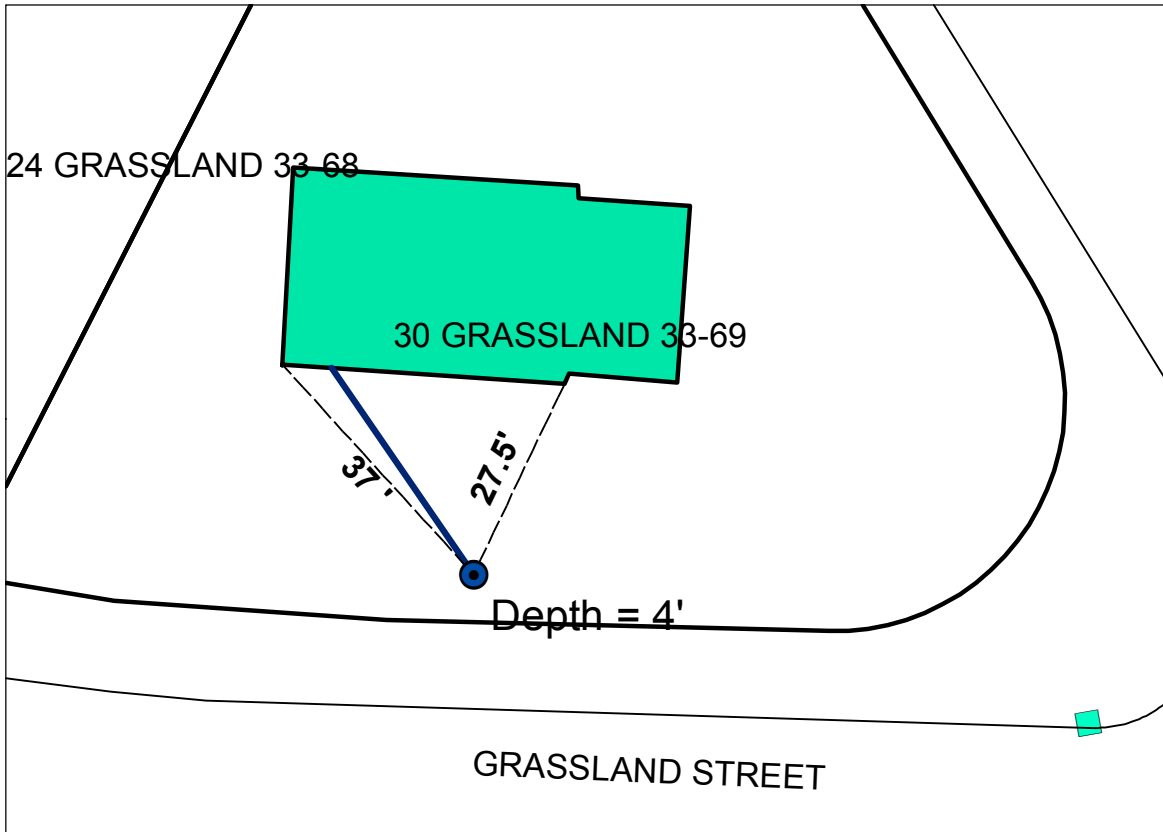

Legend

- Curb Stop
- Ties_Dimensions
- Water Service Line
- Parcel_Polys_New
- Edge of Pavement
- CATCH BASIN

Address	Map and Lot	Permit Number	Contractor Name	Inspector
30 Grassland St	33-69	5866	Bradley Landscaping	dpavlik msprague
Date	Material	Depth of Cover	Amount	
4/25/2014	3/4" Copper type "k"	4.0 ft	6"	
	3/4" to 1" fitting	4.0 ft	1	
	1" Copper type "k"	4.0 ft	1 ft	
	1" Curb Valve and Buffalo Box	5.5 ft	32 ft to house	
Type of work completed				
New 1" water service to house from curb stop. New house on lot old house removed.				