

WATER SERVICE RECORD

Name \_\_\_\_\_ Service No. \_\_\_\_\_

Address 31 Grassland Street

Location \_\_\_\_\_

Repair—Renewal—New Service


Date		Material	Amount		Total	Date		Material	Amount	
9/7/50	38	3/4 COPPER				9/7/50	32'	3/4 COPPER		
	1	3/4 x 1/2 S+W						3/4 CORP		
								3/4 CURB		
								Box + Rod		
						8/5/86		SERVICE LOWERED - INSULLATED		
								APROX 4' DEEP		

DATE \_\_\_\_\_

# TOWN OF LEXINGTON — BOARD OF PUBLIC WORKS

## WATER DIVISION

Sketch of Service Here

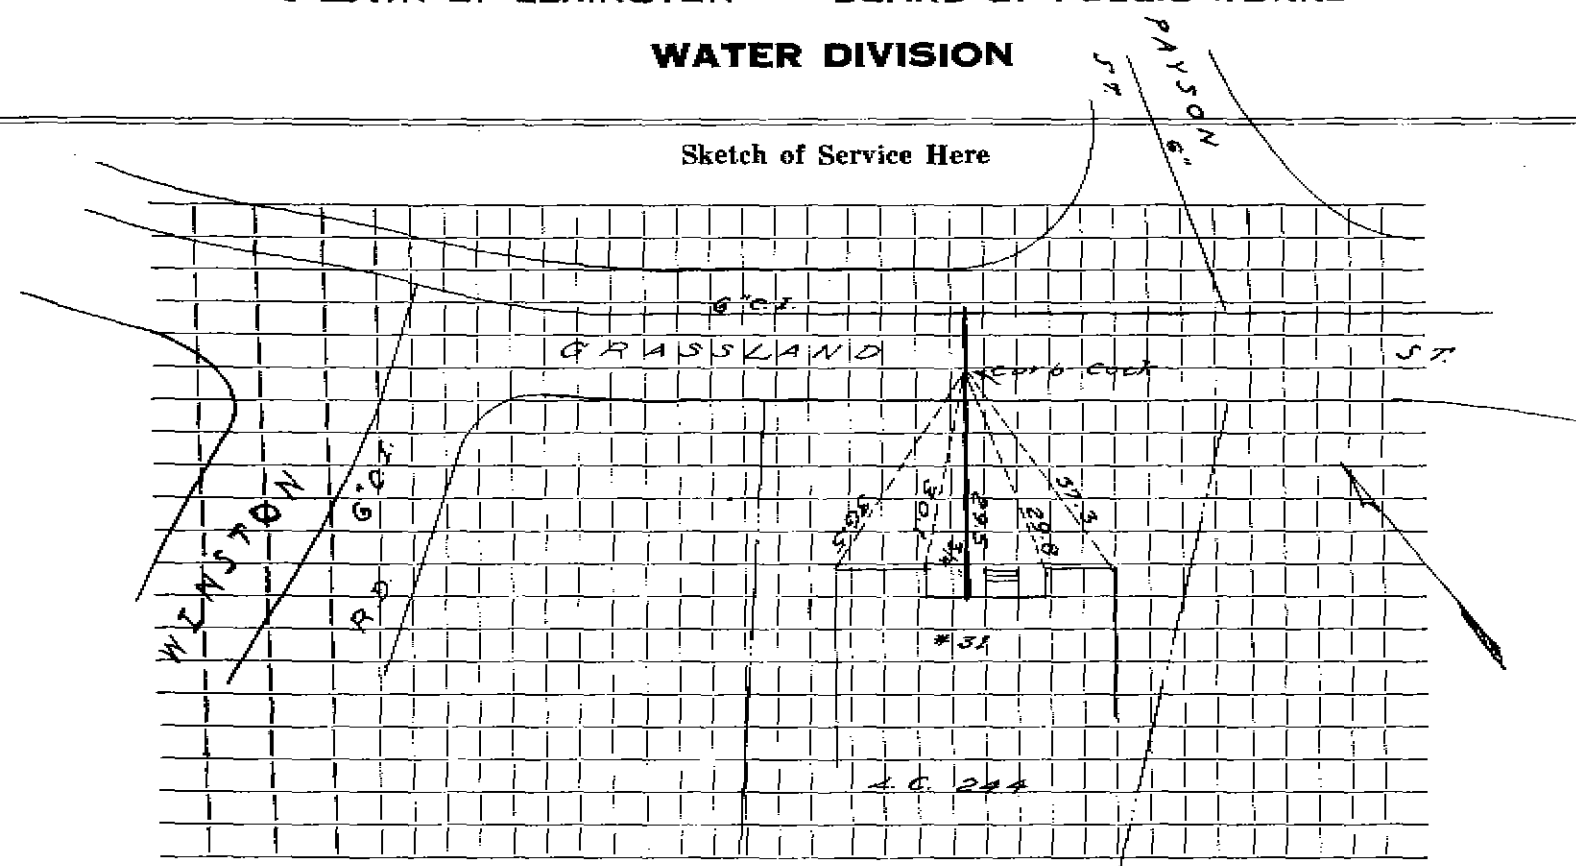

Connection made in ..... Street. Work completed .....

Remarks: .....  
.....  
.....