

WATER SERVICE RECORD

Name R. D. Hamilton Const. Co.

Service No. 60

Address 44 Grassland Street

Location Lot #189 W.O. #1042

Repair—Renewal—New Service Valeri Const. #2378


FEB 10 1975

Date	Material	Amount	Total	Date	Amount	
				11-13-73	Deposit	71.84
11-21-73	25' - 3/4" Copper					
8/31/73	Labor	13.54				
	10% O.H.	1.35	14.89			
	30' 3/4" Copper tubing @.90		27.00			
	1 3/4" Curb		11.32			
	1 3/4" Corp.		7.42			
	1 3 Part Union		3.97			
	1 Box & Rod		<u>7.34</u>			
			71.84			

DATE \_\_\_\_\_

# TOWN OF LEXINGTON — BOARD OF PUBLIC WORKS WATER DIVISION

Sketch of Service Here

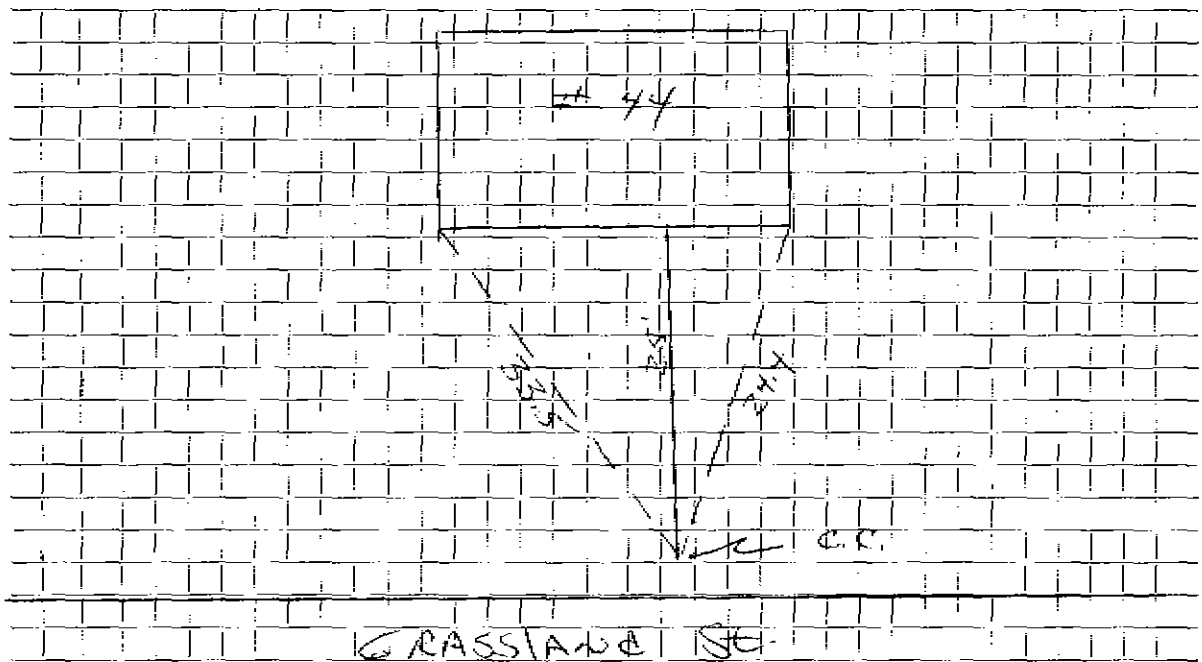

Connection made in ..... Street. Work completed .....


Remarks: .....  
.....  
.....



DATE 7-26-1999

TOWN OF LEXINGTON — BOARD OF PUBLIC WORKS  
WATER DIVISION

Sketch of Service Here

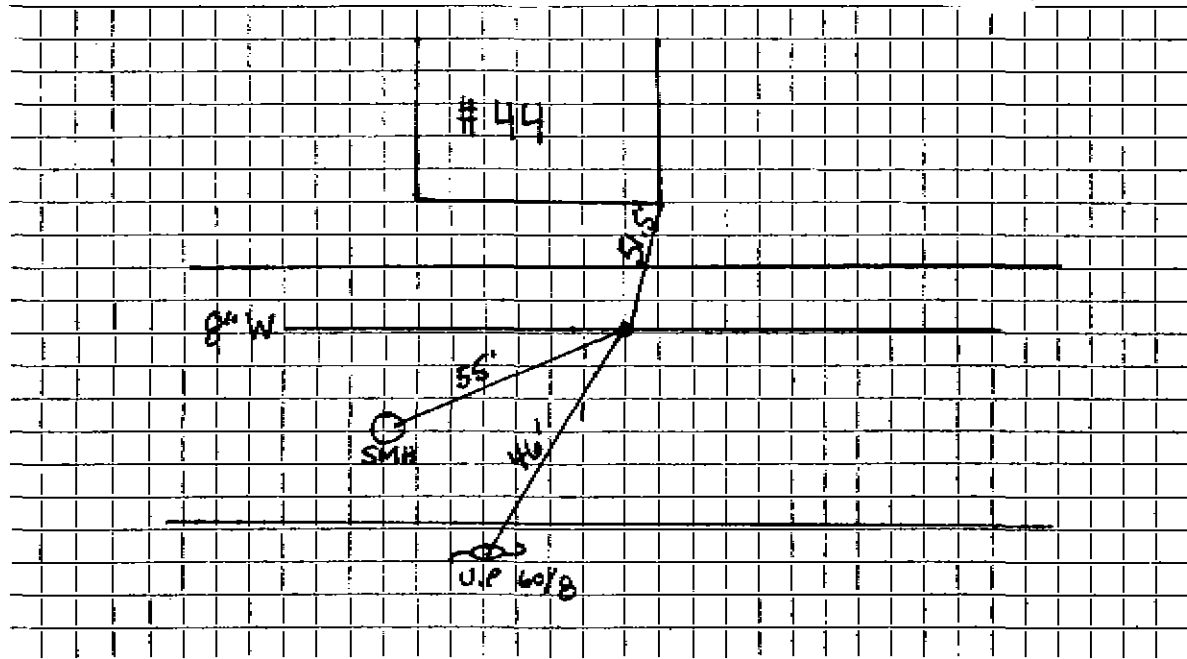

Connection made in 8\" MAIN ON GRASSLAND ST. Street. Work completed NEW CORPORATION, UNION

Remarks: 2-3 ABANDONED SERVICES LOCATED IN TRENCH TO OPPOSITE SIDE OF STREET TOWARDS LOTS/WETLANDS.  
SERVICES NOT TIED INTO NEW 8\" D.I. MAIN.