

## WATER SERVICE RECORD

Name Stratvern Realty

Service No. 9

Address 46 Grassland Street

Location

~~Repair - Renewal~~ New Service W.O. # 7603 Valeri #1556


JUL 27 1970

Date	Material	Amount	Total	Date	Amount	
5/27/70	Labor	15 08		4-25-70	Deposit	100 00
	10% O.H.	1 51	16 59	7-29-70	Refund	40 50
18'	3/4" Copper pipe	.79	14 22			59 80
1	3/4" Corporation		9 57			
1	3/4" Curb Stop		11 32			
	Box & Rod		5 10			
1	Hr. trucking		3 00			
			<u>159 80</u>			
6-1-70	36' 3/4" Copper tubing					

DATE \_\_\_\_\_

TOWN OF LEXINGTON -- BOARD OF PUBLIC WORKS  
**WATER DIVISION**

Sketch of Service Here

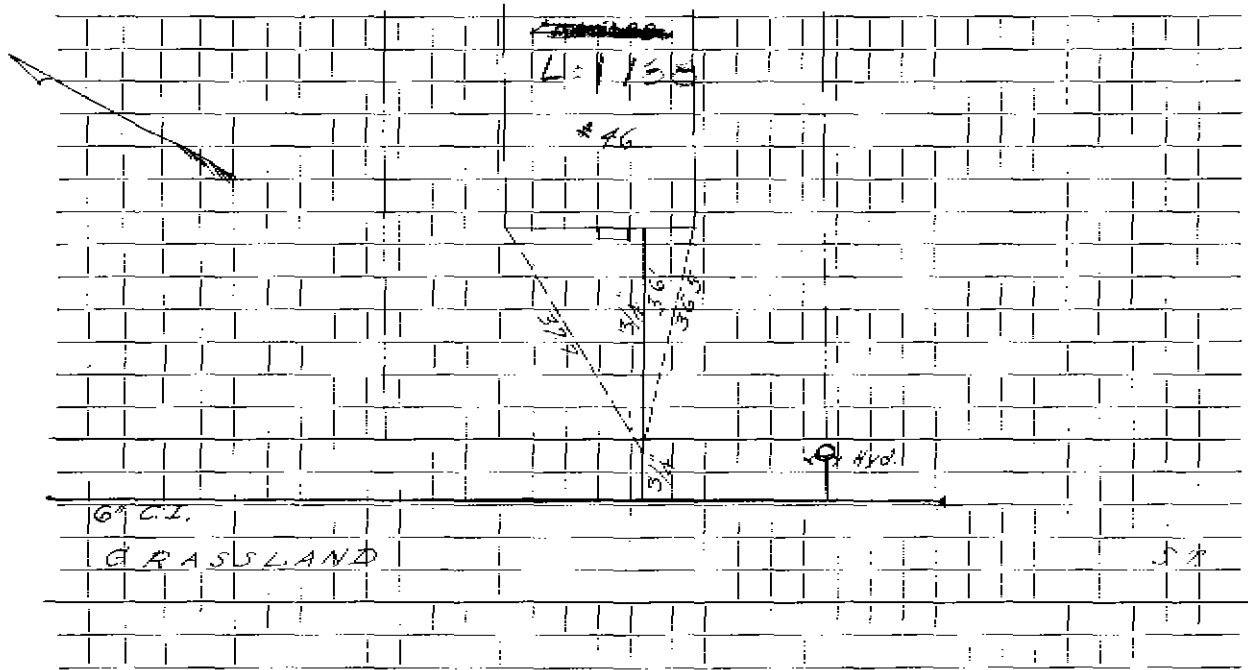

Connection made in ..... Street. Work completed .....


Remarks: .....  
.....  
.....



DATE 7-26-1999

TOWN OF LEXINGTON — BOARD OF PUBLIC WORKS  
WATER DIVISION

Sketch of Service Here

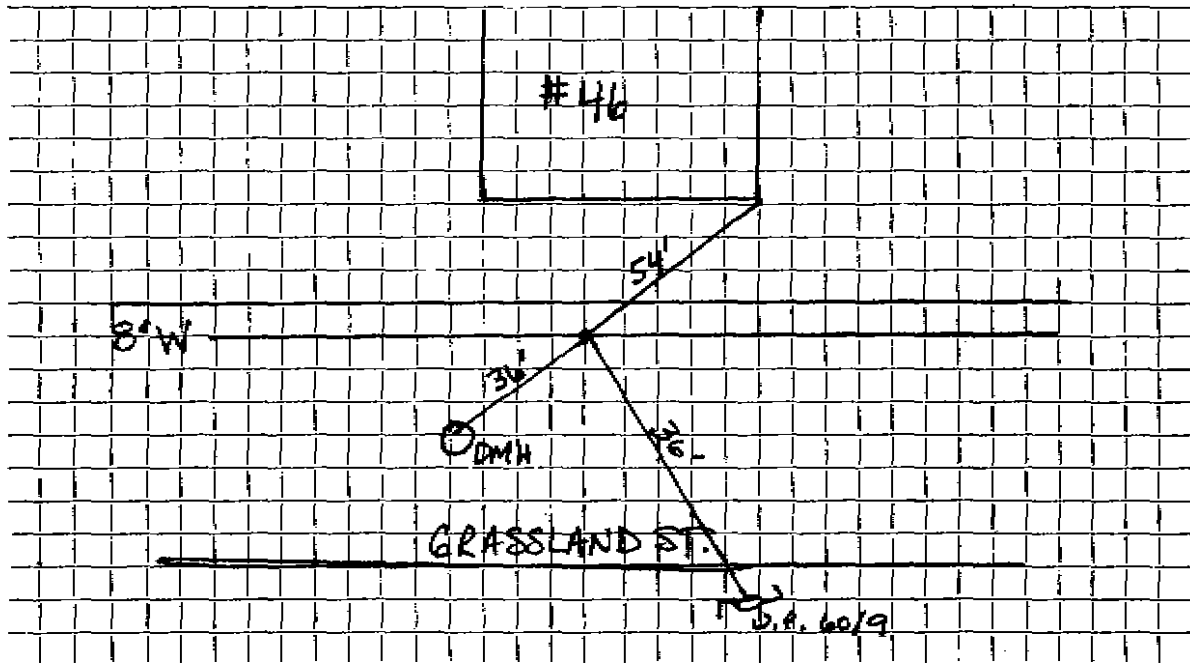

Connection made in 8" MAIN ON GRASSLAND ST. Street. Work completed NEW CORPORATION, UNION

Remarks: 2-3 SERVICES ABANDONED IN TRENCH; SERVICES CROSS OVER TO LOTS/WETLANDS. NO DWELLINGS