

WATER SERVICE RECORD

Name

52

Service No.

Address

GRASSLAND ST.

Location

CORPORATION OFF 8th MAIN ON GRASSLAND ST.

Repair

~~Renewal~~

New Service

WATER MAIN CLEANING & LINING PROJECT C99-02 : Biszko Co.

Date	Material	Amount	Total	Date	Amount
------	----------	--------	-------	------	--------

7-26-1999


	3' 1" COPPER BTW CORPORATION & UNION				
	1 CORPORATION				
	1 UNION				

DATE 7-26-1999

TOWN OF LEXINGTON — BOARD OF PUBLIC WORKS

WATER DIVISION

Sketch of Service Here

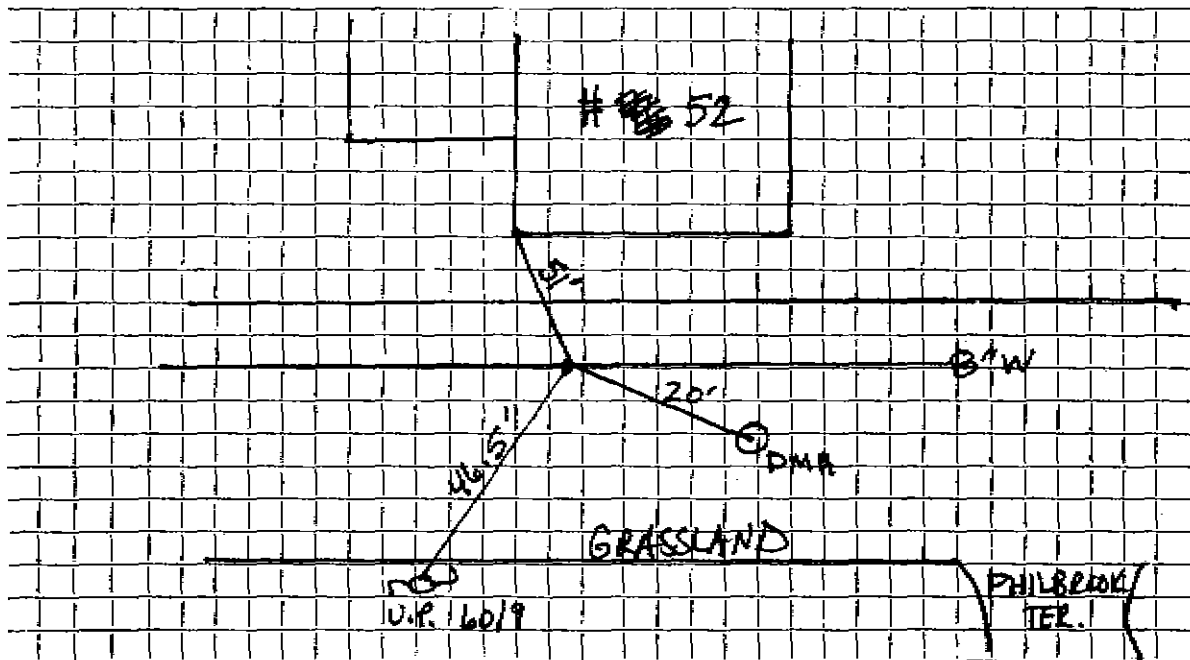

Connection made in 8" MAIN ON GRASSLAND ST. Street.

Work completed NEW CORPORATION, UNION

Remarks:

WATER SERVICE RECORD

Name Mr. Peter Sowkow

Service No. 52

Address 52 Grassland St.

Location

*~~Repair~~ ~~Renewal~~ — New Service W.O.# 7315 Cont. DeFliceBros

JAN 27 1969


Date		Material	Amount		Total		Date	Amount	
9/25/68		Labor	5	12			7-30-68	120	00
		10% O.H.		51			1-27-69	76	48
					5	63		43	52
	15	3/4" Copperpipe @.79			11	85			
		3/4" Curb Stop			8	37			
		3/4" Corporation			9	57			
		Box & Rod			5	10			
	1	Hr. Trucking			3	00			
10-11-68	40'	3/4" Copper tubing			43	52			

DATE _____

TOWN OF LEXINGTON — BOARD OF PUBLIC WORKS

WATER DIVISION

Sketch of Service Here

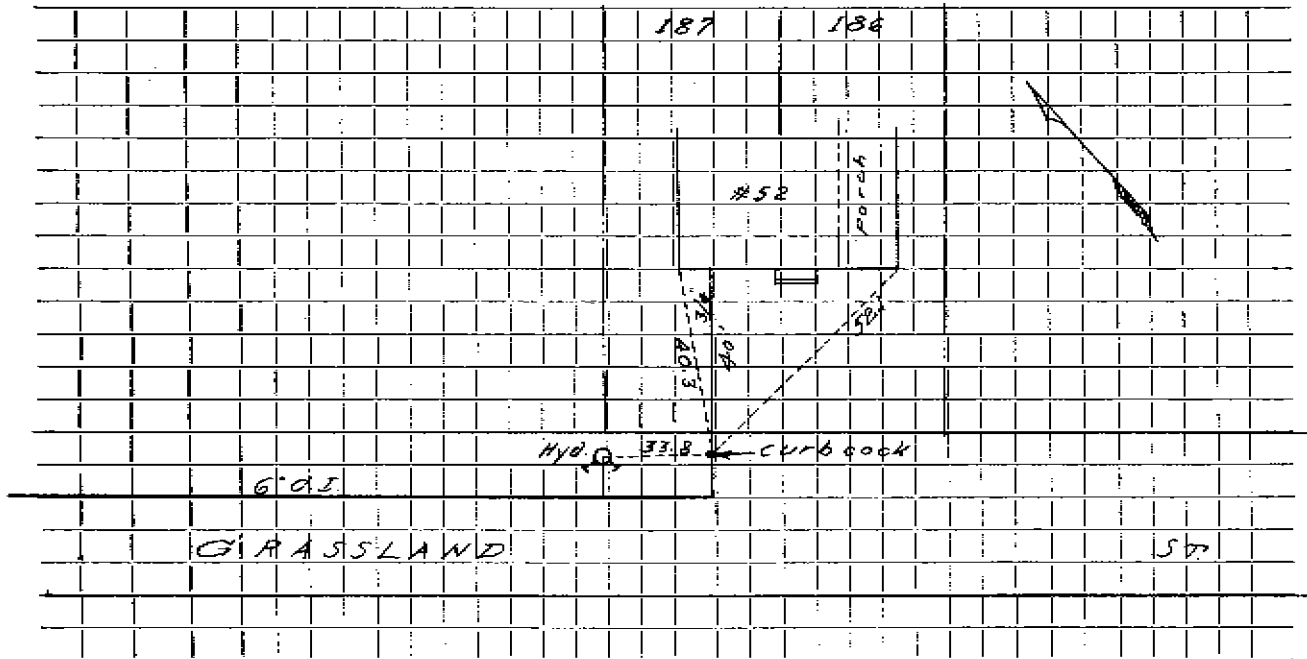

Connection made in Street. Work completed

Remarks:

.....

.....