

WATER SERVICE RECORD

Name

Service No.

Address

55 GRASSLAND ST.

Location

Repair—Renewal—New Service

Date	Material	Amount	Total	Date	Amount
	38' 3/4" Copper			8-30-73	
				38' 3/4" Copper	
				1 3/4" C. Corp	
				1 3/4" C. Curb	
				1 3/4" - 3 Part Union	

~~38' 3/4" Copper~~

8-30-73

38' 3/4" Copper

1 3/4" C. Corp

1 3/4" C. Curb


1 3/4" - 3 Part Union

DATE _____

TOWN OF LEXINGTON — BOARD OF PUBLIC WORKS

WATER DIVISION

Sketch of Service Here

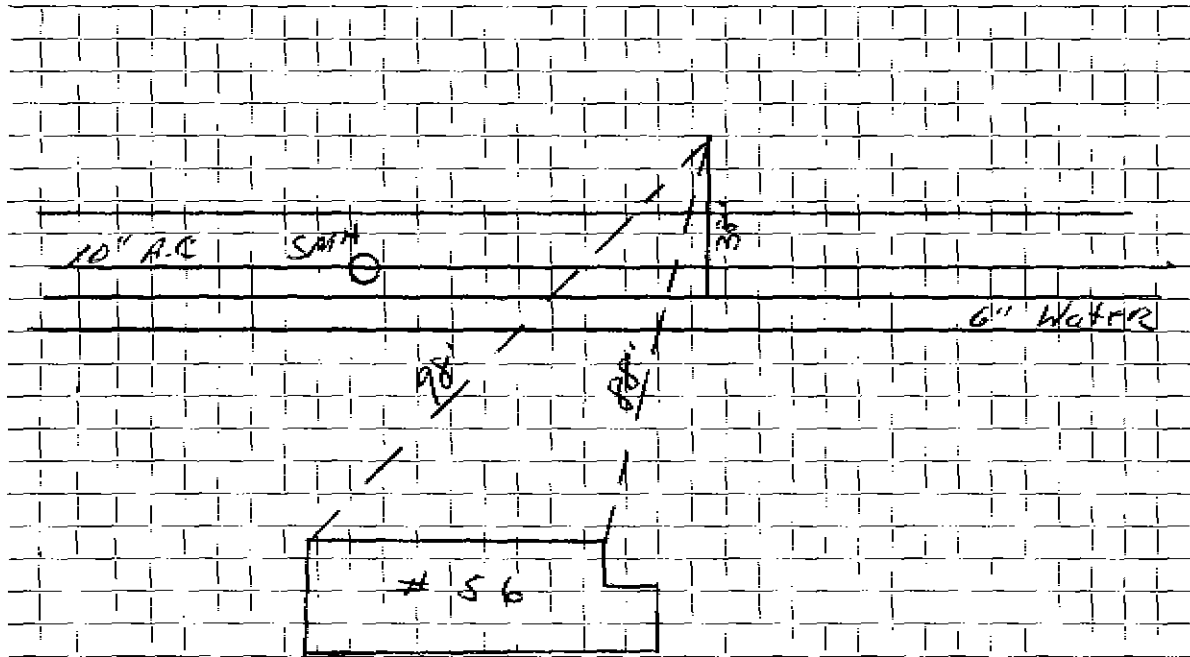

Connection made in Street. Work completed

Remarks:

.....

.....