

WATER SERVICE RECORD

Service No. 102

Name Peter Sawkow

Address 56 Grassland Street

Location

~~RENEW~~—~~RENEWAL~~—New Service O L D Excavating #510

SEP 5 1967

| Date | | Material | Amount | | Total | Date | Amount |
|---------|-------|--------------------|--------|----|--------|------|--------|
| 1/5/67 | | Labor | 43. | 05 | | | |
| | | 10% O. H. | 4. | 31 | 47. 36 | | |
| | 18' | 3/4" Copper Tubing | | | 14. 22 | | |
| | 1 | 3/4" Corp. Cock | | | 7. 42 | | |
| | 1 | 3/4" Curb Cock | | | 8. 76 | | |
| | 1 | Box and Rod | | | 5. 10 | | |
| | 1 1/2 | Hrs. Shovel @6.50 | | | 9. 75 | | |
| | 1 1/2 | Hrs. Trucking | | | 4. 50 | | |
| | 1/2 | Hr. Loader | | | 2. 00 | | |
| | | | | | 99. 11 | | |
| 1-20-67 | 40' | 3/4" Copper tubing | | | | | |
| | | | | | | | |
| | | | | | | | |
12-46
10-2067

Deposit


50 00
49 11
—
99 11

Bill sent 99.11

DATE _____

TOWN OF LEXINGTON — BOARD OF PUBLIC WORKS
WATER DIVISION

Sketch of Service Here

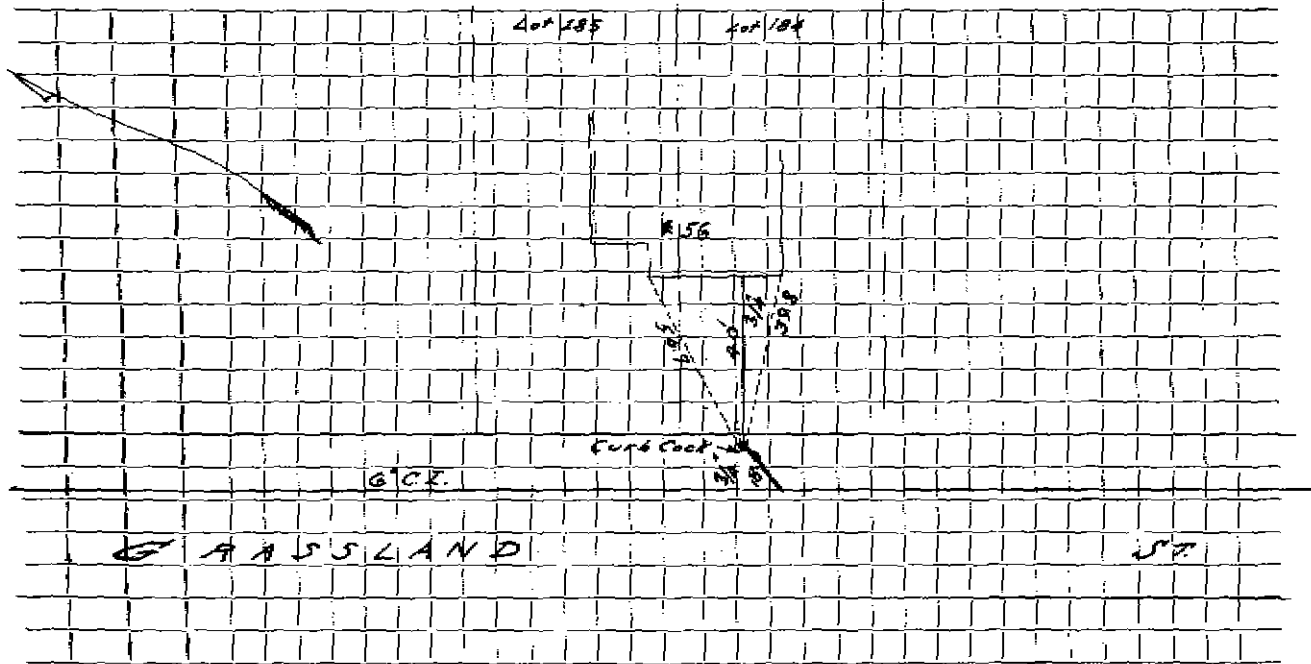

Connection made in Street. Work completed

Remarks:

.....

.....