

WATER SERVICE RECORD

Name

Service No.

Address

57 Grassland Street

Location

Lot#33.

~~Repair—Renewal~~—New Service W.O.#1052


Date	Material	Amount	Total	Date	Amount
8-29-'73	Labor	13.04			
	10% Overhead	1.30	\$14.34		
	50' 3/4" Copper Tubing @.79		39.50		
	1 3/4 Curb		11.32		
	1 3/4 Corporation		7.42		
	1 Box & Rod		7.34		
			<u>\$79.92</u>		

DATE \_\_\_\_\_

TOWN OF LEXINGTON — BOARD OF PUBLIC WORKS

**WATER DIVISION**

Sketch of Service Here

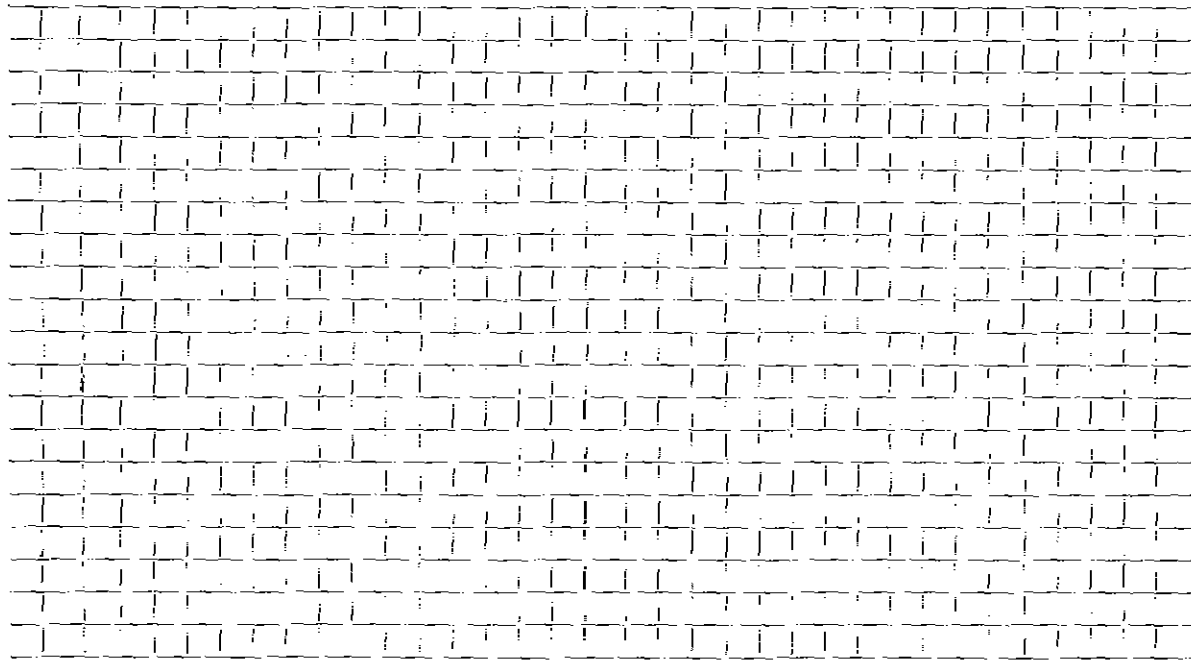

Connection made in ..... Street.      Work completed .....

Remarks: .....

.....

.....




DATE \_\_\_\_\_

TOWN OF LEXINGTON — BOARD OF PUBLIC WORKS

**WATER DIVISION**

Sketch of Service Here

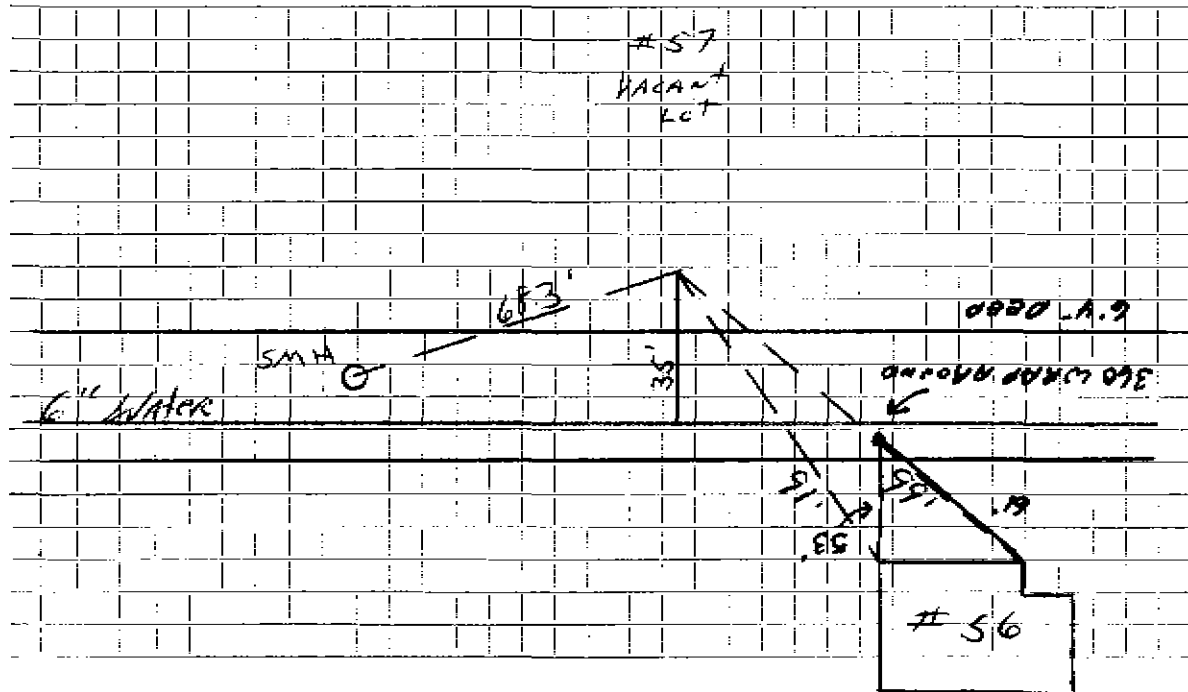

Connection made in ..... Street. Work completed .....

Remarks: .....

.....

.....