

WATER SERVICE RECORD

Name	Service No.
Address	63 Grassland Street
Location	Lot #36,
Repair Required	New Service W.O. #1062.


DATE _____

TOWN OF LEXINGTON — BOARD OF PUBLIC WORKS

WATER DIVISION

Sketch of Service Here

LOT 36

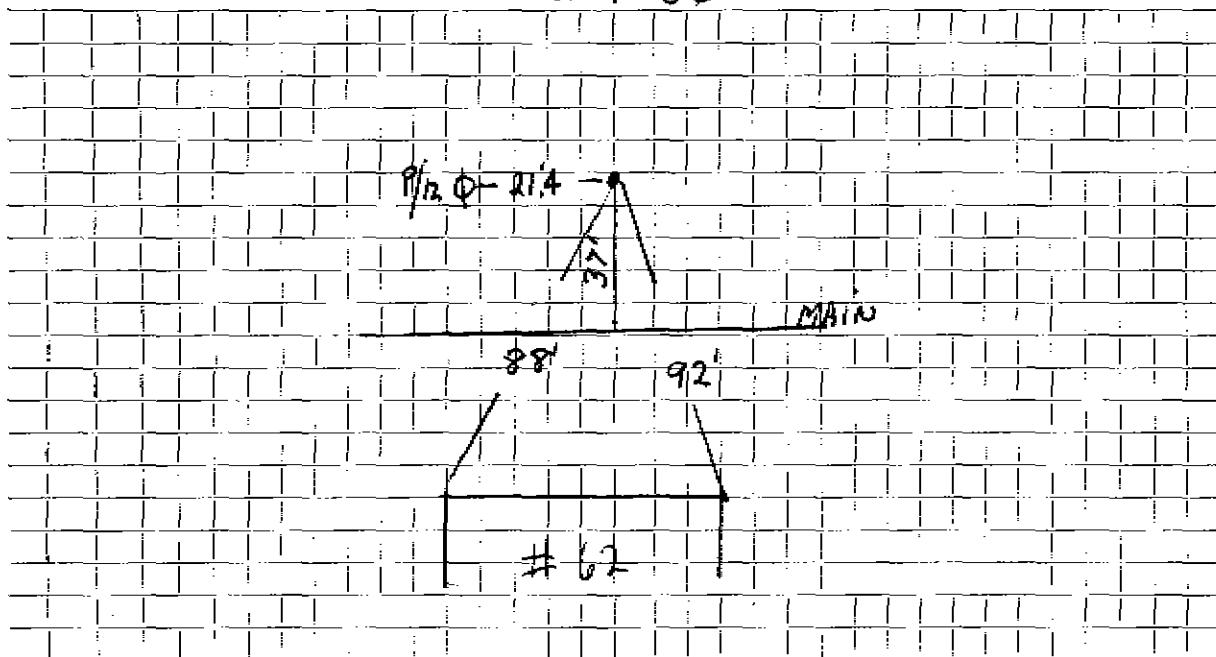

Connection made in Street. Work completed

Remarks: