

WATER SERVICE RECORD

Name Donna Realty Trust

Service No. 33

Address 64 Grassland Street

Location

Repair—Renewal—New Service W.C.#6710 Valeri #1432

SEP 2 1969


Date	Material	Amount	Total	Date	Amount
8-14-69	Labor	11.94		8-5-69	Deposit 100 00
	10% G.H.	1.19	13.13	9-2-69	Retard 46 54
16'	3/4" Copper tubing @.79		12.64		53 26
1	3/4" Corp. Cock		9.57		
1	3/4" Curb Cock		11.32		
1	Box & Rod		5.10		
1	hr. Trucking		1.50		
			53.26		
8-21-69	40' 3/4" Copper tubing				

DATE \_\_\_\_\_

TOWN OF LEXINGTON — BOARD OF PUBLIC WORKS

**WATER DIVISION**

Sketch of Service Here

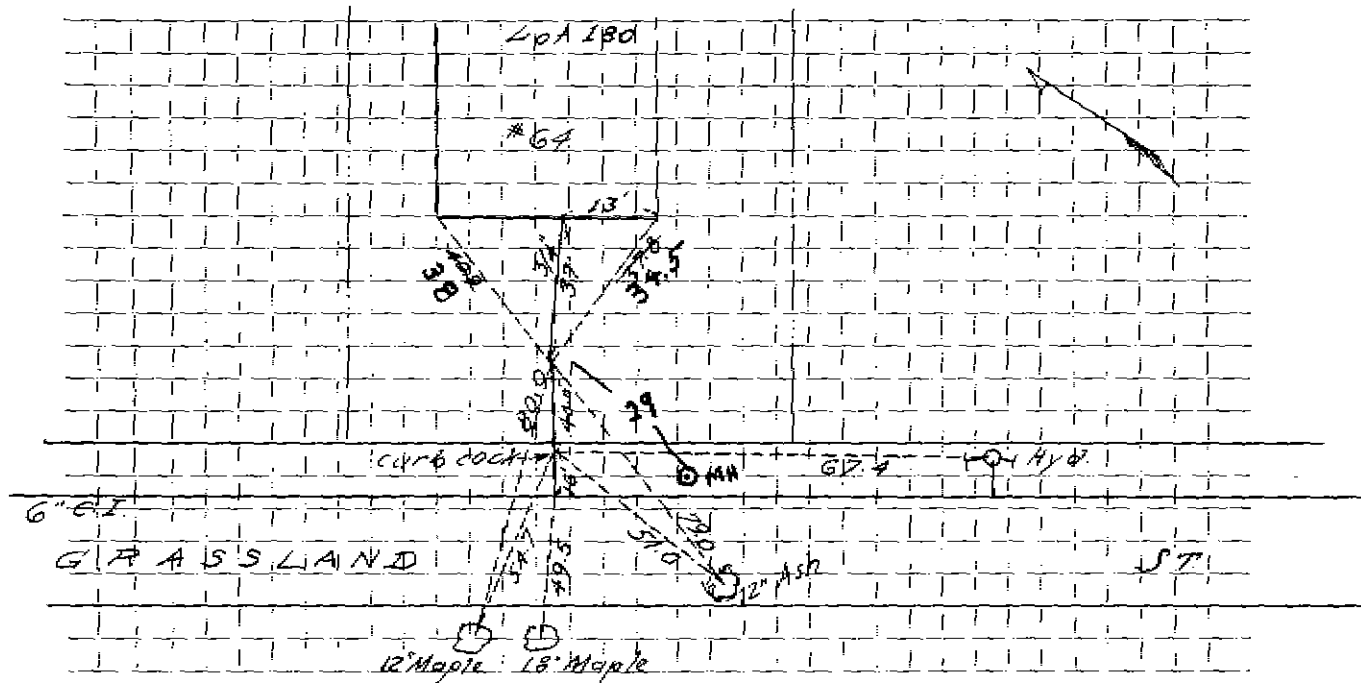

Connection made in ..... Street.                      Work completed .....

Remarks: .....

.....

.....