

WATER SERVICE RECORD

3370

Name Anna Valihura

Service No. 290

Address 67 Grassland St.

Location

~~REPAIR WORK~~ - New Service

Com 12-31-54


Date	Material	Amount	Total	Date	Amount
11/22/54	Labor	40 37		11-19-54	Deposited 375 00
	10% overhead	4 04	44 41	12-31-54	Refunded (61 11)
	300' - 1" copper tubing @ .4956	148 68			NON CHARGE 313 89
	1 - 1"C x 3/4" I.W.H. stop & waste	1 50		11/23/54	Labor 15 25
	5 - 1"C x 1"C. unions @ 2.26	11 30			33' - 1" copper tubing @ .4956 16 35
	50 yds. gravel @ .60	30 00			1 - 1"C. corp-cock 5 61
	6 hrs. Littlefield shovel @ 7.50	45 00			1 - 1"C. curb-cock 6 80
	6 hrs. Allis Chalmers @ 3.00	18 00			1 - box and rod 3 90
	4 hrs. trucking @ 3.00	12 00			1 - 3/4" Straight tail pc. 50
			313 89		1 - 3/4" offset tail pc. 50
	PART OF COPPER SUPPLIED & LAID BY OWNER:				2 hrs. Littlefield shovel @ 7.50 15 00
					1 hr. trucking 75
					64 66

DATE _____

TOWN OF LEXINGTON — BOARD OF PUBLIC WORKS

WATER DIVISION

Sketch of Service Here

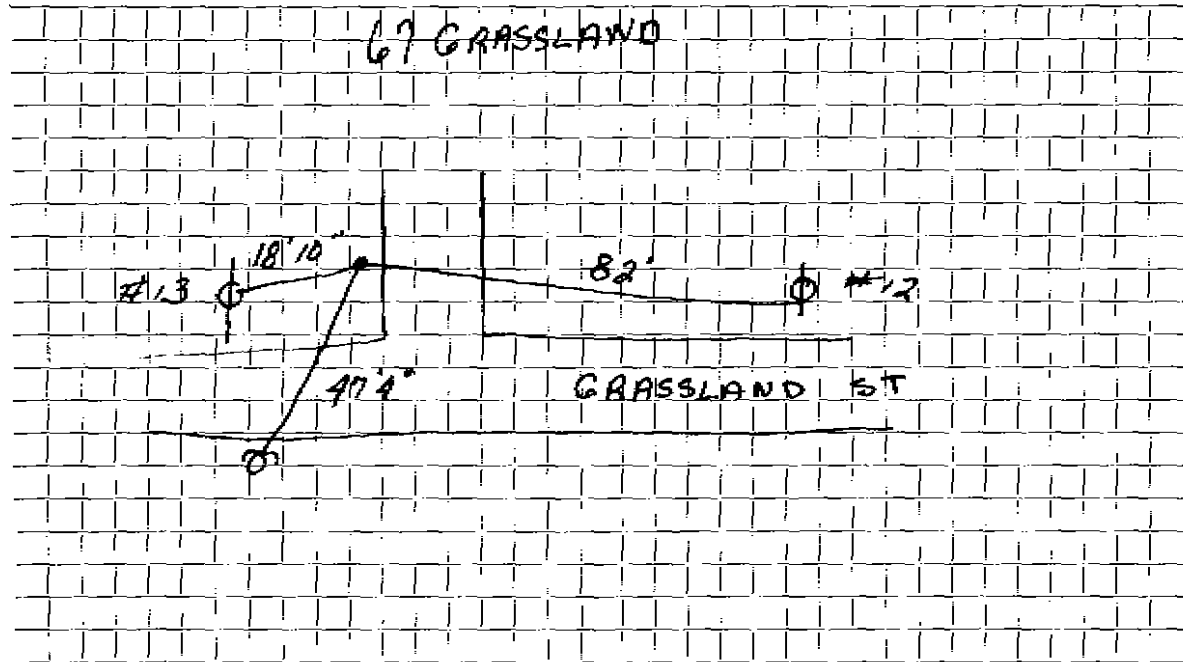

Connection made in Street. Work completed

Remarks:

.....

.....