

6747

WATER SERVICE RECORD

Name Donna Realty Trust

Service No. 35

Address 70 Grassland St.

Location

~~Repair~~ ~~RENEWAL~~—New Service W.O. #6714 Valeri #1434

SEP 2 1969


Date	Material	Amount	Total	Date	Amount
8/19/69	Labor	11 94			
	10% O.H.	1 19	13 13		
	12' 3/4" Copper pipe .79		9 48		
	3/4" Corporation		9 57		
	3/4" Curb stop		11 32		
	Box & Rod		5 10		
	1 Hr. Trucking		1 50		
			50 10		
8-21-69	45' 3/4" Copper tubing				

DATE _____

TOWN OF LEXINGTON -- BOARD OF PUBLIC WORKS

WATER DIVISION

Sketch of Service Here

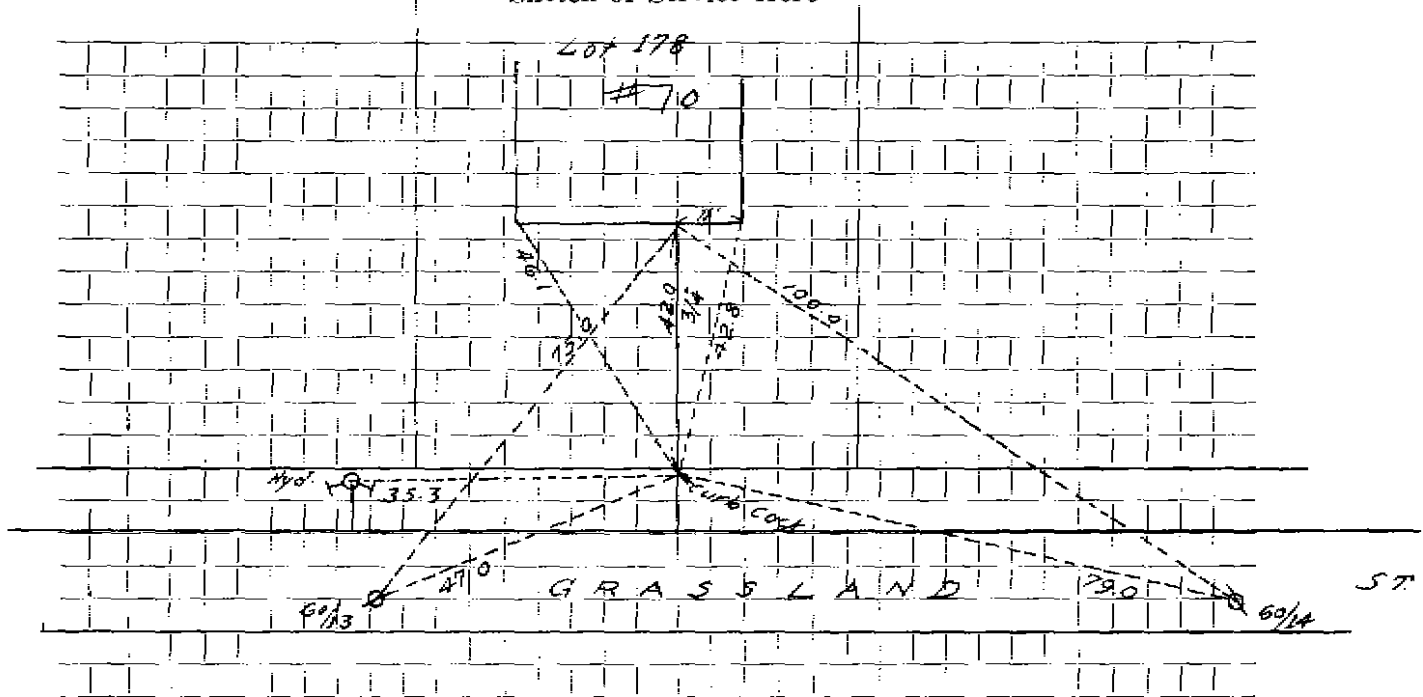

Connection made in Street. Work completed

Remarks:

.....

.....