

## WATER SERVICE RECORD

Name *Ronald DeMille*Service No. *2*Address *71 Grassland Street*

Location

~~Repair~~ ~~Renewal~~ ~~New Service~~ *W.O. #1066. Kirkland & Shaw #3824*

OCT 31 1983


Date	Material	Amount	Total	Date	Amount
8-23-73	Labor	18.72		<i>7/5/83</i>	<i>Deposit</i>
	10% O.H.	1.87	\$20.59		<i>75.11</i>
36'	3/4" Copper Pipe @ .79		28.44		
1	3/4 Corporation		7.42		
1	3/4 Curb Cock		11.32		
1	Box & Rod		<u>7.34</u>		
			\$75.11		
9/27/83	462' 1" Copper tubing				
	5' 1" 3 Part Unions				
	1 3/4" x 1" 3 Part Unions				

DATE \_\_\_\_\_

TOWN OF LEXINGTON — BOARD OF PUBLIC WORKS

WATER DIVISION

Sketch of Service Here

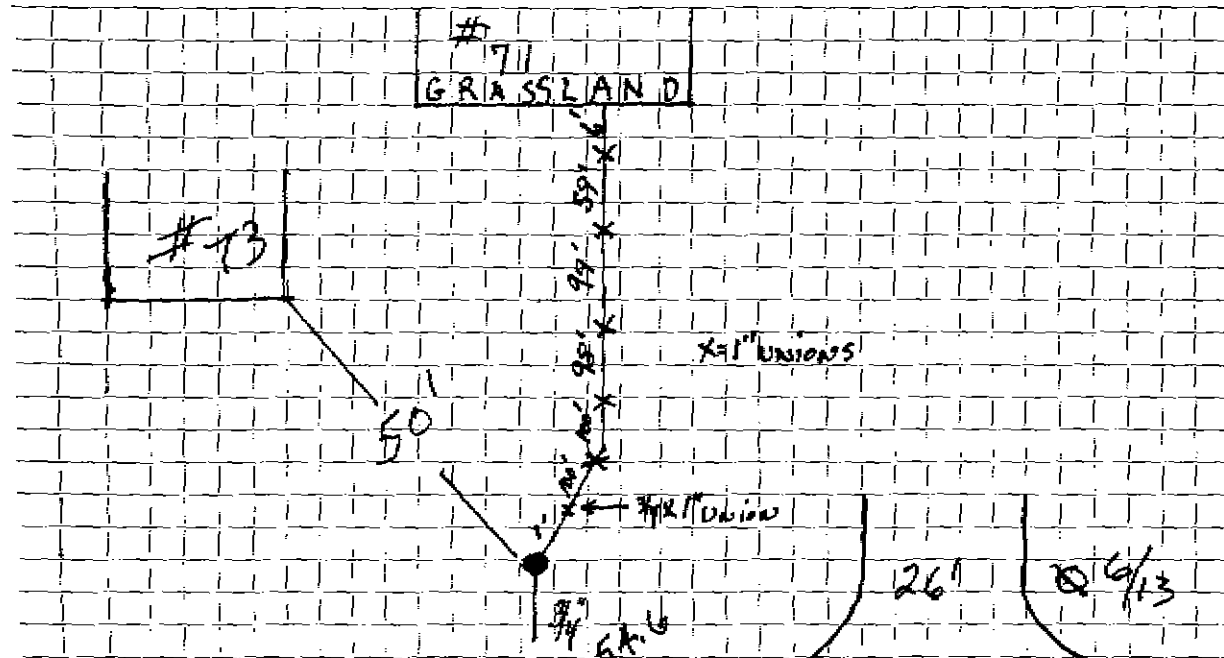

Connection made in ..... Street. Work completed .....

Remarks: .....

.....

.....