

# 6554

WATER SERVICE RECORD

Name Stratvern Realty

Service No. 10

Address 72 Grassland Street

Location \_\_\_\_\_

Report ~~by~~ New Service W.O. # 7605 Valeri # 1557


**JUL 27 1970**

Date	Material	Amount	Total	Date	Amount
5/4/70	Labor	14 04		4-22-70	Deposit 100 00
	10% O.N.	1 40	15 44	7-27-70	Retard 43 72
15'	3/4" Copper pipe .79		11 85		54 38
	3/4" Corporation		9 57		
	3/4" Curb stop		11 32		
	Box & Rod		5 10		
1	Hr. trucking		3 00		
			<u>56 28</u>		
6-2-70	38' 3/4" Copper tubing				

DATE \_\_\_\_\_

**TOWN OF LEXINGTON — BOARD OF PUBLIC WORKS**  
**WATER DIVISION**

Sketch of Service Here

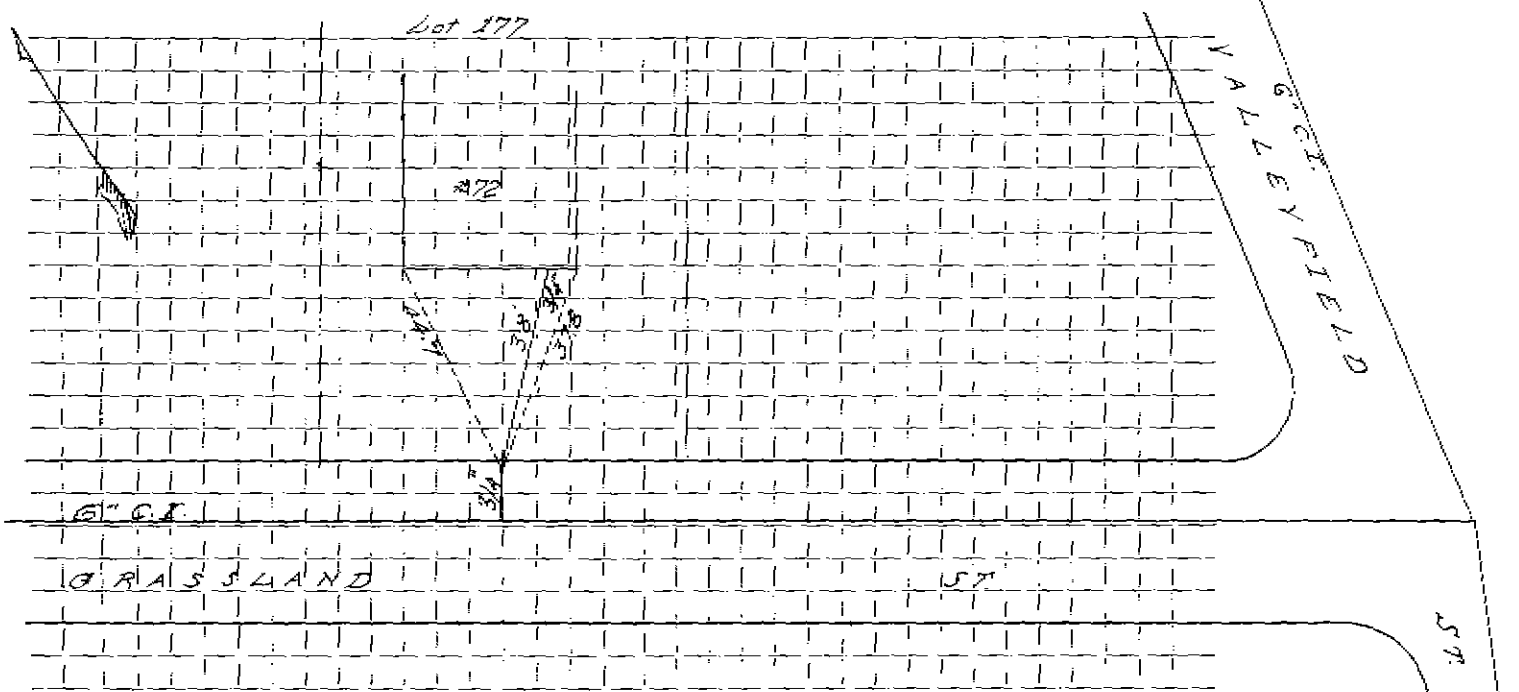

Connection made in ..... Street. Work completed .....

Remarks: .....

.....

.....