

WATER SERVICE RECORD

Name Barbara DeMille

Service No. 44

Address 73 Grassland Street

Location Lot # 40.

~~Repair and Renewal~~ - New Service W.O. #1068. DeFlice #3204

DEC 26 1978


Date	Material	Amount	Total	Date	Amount	
8-22-73	Labor	14.78		11/4/78	Deposit	68.41
	10% O.H.	1.48	16.26			
	33' 3/4" Copper Tubing @ .79		26.07			
	1 3/4 Corporation		7.42			
	1 3/4 Curb Cock		11.32			
	1 Box & Rod		7.34			
			\$68.41			
11/30/78	39' 1" Copper tubing					

DATE _____

TOWN OF LEXINGTON — BOARD OF PUBLIC WORKS

WATER DIVISION

Sketch of Service Here

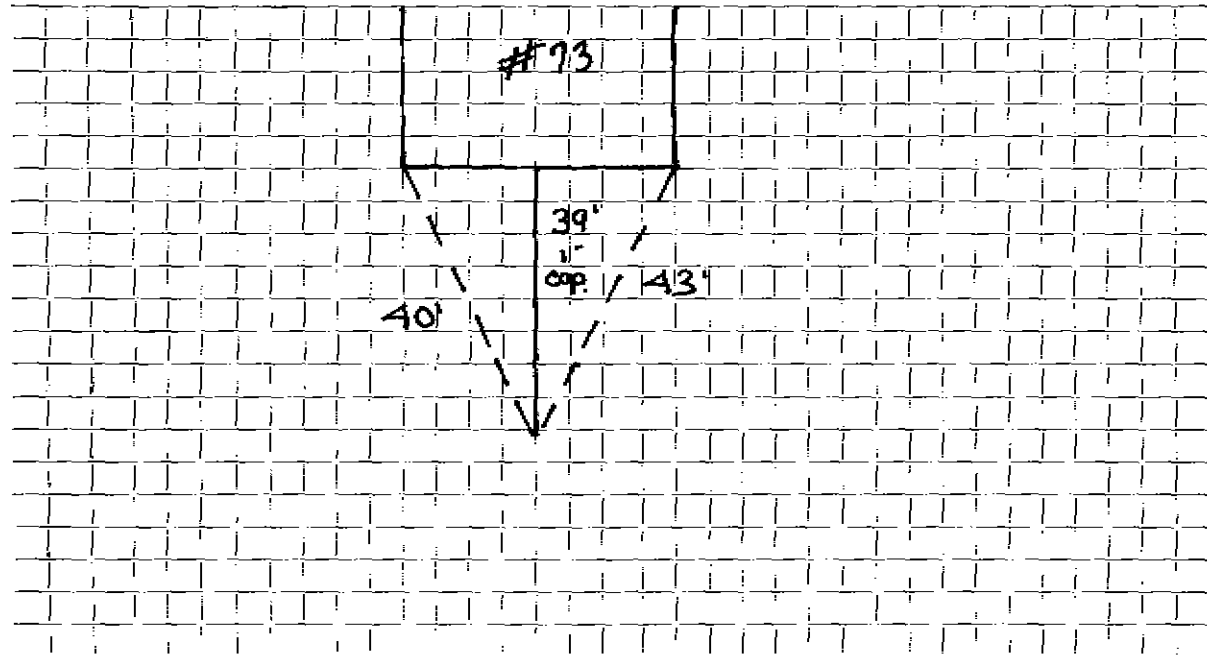

Connection made in Street. Work completed

Remarks:

.....

.....