

WATER SERVICE RECORD

1424

Name Donna Realty Trust

Service No. 48

Address 74 Grassland St.

Location

~~Repair~~ ~~Renewal~~ ~~New Service~~ W.O. # 6873 Valeri #1461


DEC 28 1969

Date	Material	Amount	Total	Date	Amount
9/23/68	Labor		13 34	11-25-69	100 00
	105 G.V.		1 33	12-22-69	46 70
16'	3/4" Copper pipe	1.72	12 60		53 30
	3/4" Corporation		9 57		
	3/4" Gurb Stop		12 32		
	Box & rod		5 70		
			53 00		
10-2-69	35' 3/4" Copper tubing				

DATE _____

TOWN OF LEXINGTON — BOARD OF PUBLIC WORKS
WATER DIVISION

Sketch of Service Here

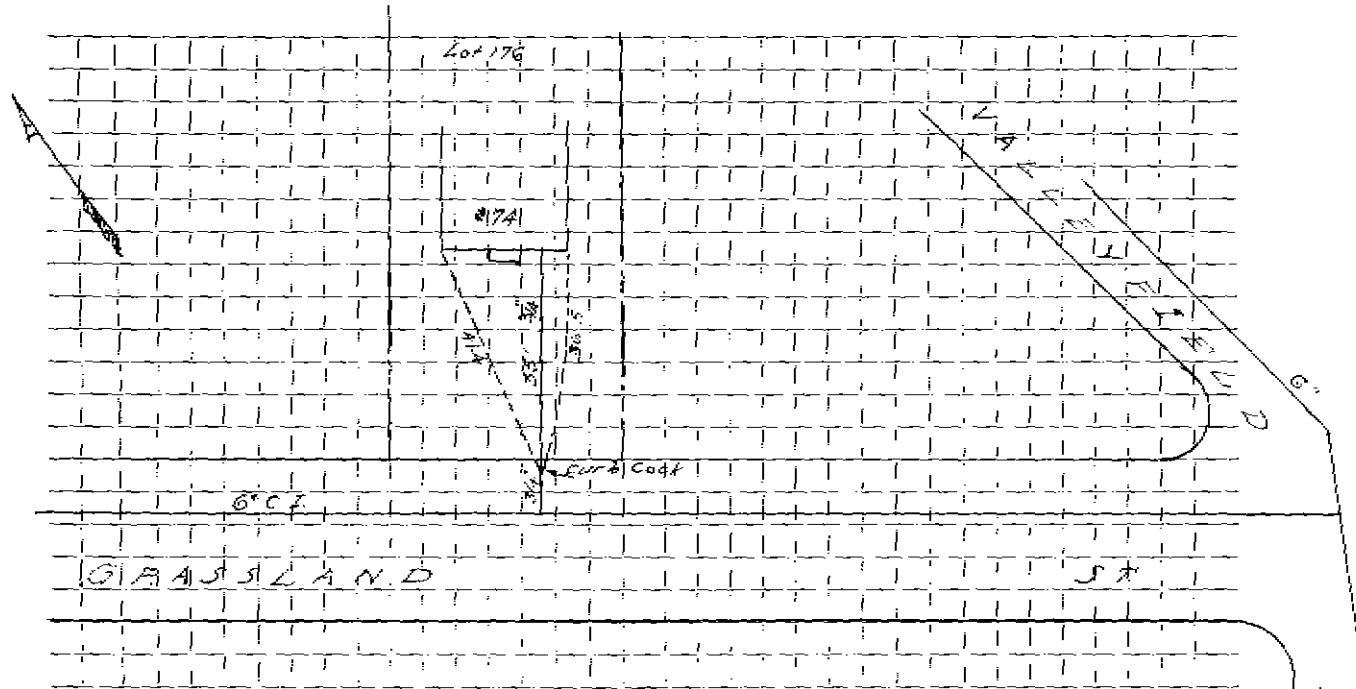

Connection made in Street. Work completed

Remarks:
.....
.....