

WATER SERVICE RECORD

Name Antonio Caira

Service No. 44

Address 75 Grassland Street

Location

Repair—Renewal—New Service W.O. #1072 Valeri #3136


NOV 19 1973

Date	Material	Amount	Total	Date	Amount	
8/22/73	Labor	14.78		9-11-73	Deposit	70.00
	10% O.H.	1.49	16.27			
	35' 3/4" Copper tubing @.79		27.65			
	1 3/4" Corp Cock		7.42			
	1 3/4" Curb Cock		11.32			
	1 Box & Rod		7.34			
			70.00			
9/13/73	50' 3/4" Copper tubing					

DATE _____

TOWN OF LEXINGTON — BOARD OF PUBLIC WORKS
WATER DIVISION

Sketch of Service Here

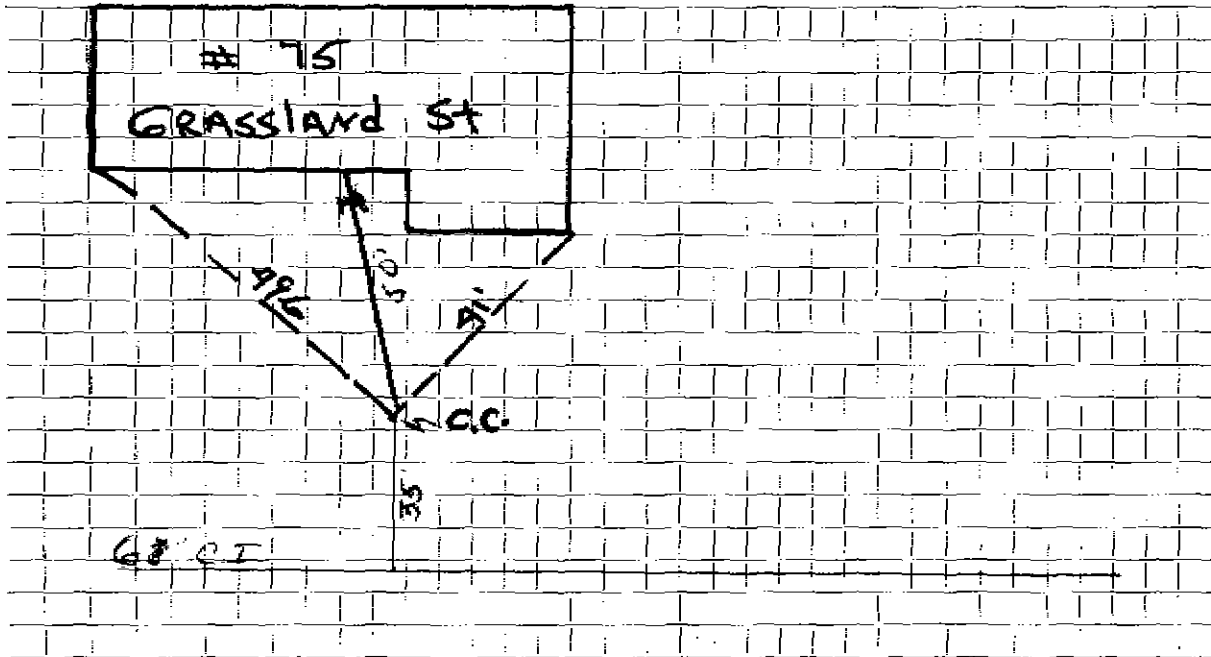

Connection made in Street. Work completed

Remarks:

.....

.....