

WATER SERVICE RECORD

Name John W. Toulan, Jr.

Service No. 225

Address 1 Great Rock Road

Location Lexington, Mass.

XXXXXX  
~~Repair~~ ~~Renewal~~ — New Service

*Jan. 11-18-51*


Date	Material	Amount	Total	Date	Material	Amount
10/9/51	Labor	5 30	5 30	9-15-51	Deposited	60 00
	10% overhead		53	11-13-51	Refunded	2 56
	60' -3/4" copper tubing@.326	19 56	19 56		<u>NON CHARGE</u>	57 14
	1 -3/4" Cx 1/2 I.W.H. stop&waste	4 00	4 00	10/9/51	Labor	10 12
	3 hrs. Littlefield shovel@7.00	21 00	21 00	15' - 3/4" cooper tubing@.326		4 89
	1 hr. trucking		75	1 -3/4" C. corp-cock		4 33
	patching 6 x 3		6 00	1 -3/4" C x 3/4" C. curb-cock		4 67
			57 14	1 box end rod		4 68
				1-1/2 offset tail piece		50
				1-1/2 straight tail piece		50
				2 hrs. Littlefield shovel@7.00		14 00
				1 hr. trucking		75
						44 44

DATE \_\_\_\_\_

# TOWN OF LEXINGTON — BOARD OF PUBLIC WORKS

## WATER DIVISION

Sketch of Service Here

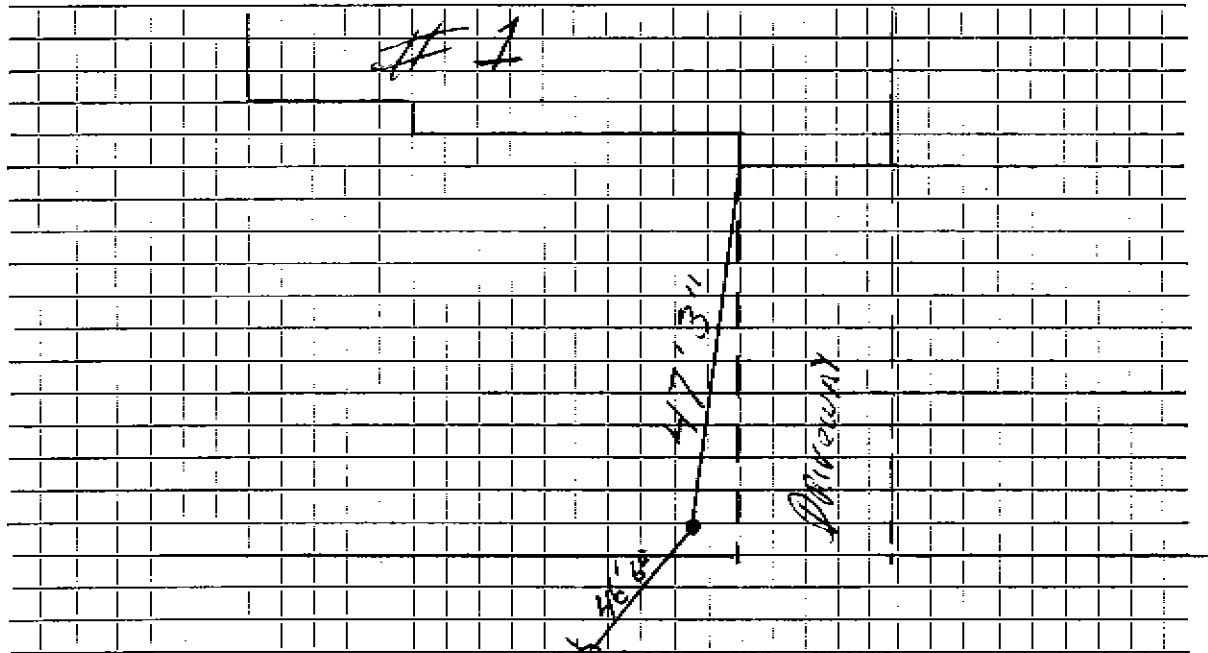

Connection made in ..... Street. Work completed .....

Remarks: .....

.....

.....