

WATER SERVICE RECORD

Name Bernard C. Maloney

Service No. 50

Address 4 Great Rock Road

3071

Location

~~Repair~~ ~~Renewal~~ New Service

Am. 5-3-54


Date	Material	Amount	Total	Date	Amount
3/30/54	Labor	6 65		3-30-54 Deposited	25 00
	10% overhead	67	7 32	5-3-54 Refunded	(18 13)
	38' 3/4" Copper tubing @.35	13 30			56 87
	1-3/4" Cx 1/2" I.W.F. Stop & waste	1 60		3/30/54	NON CHARGE
	1 hr Littlefield shovel	7 50			Labor
	1 hr trucking	75		28' 3/4" Copper tubing @.35	9 80
	Patching 2 1/2 x 3	24 00		1-3/4" 2.0 Corp Cock	1 33
		56 87		1-3/4" Cx 3/4" C. Curb cock	1 67
				1- Box 5 rod	3 90
				2-3/4" Cx 3/4" C. Union (3 parts)	3 44
				1- 3/8" Straight tail piece	50
				1- 1/2" Offset tail piece	50
				1 hr Littlefield shovel	7 50
				1 hr trucking	75
					42 04

DATE _____

TOWN OF LEXINGTON — BOARD OF PUBLIC WORKS

WATER DIVISION

Sketch of Service Here

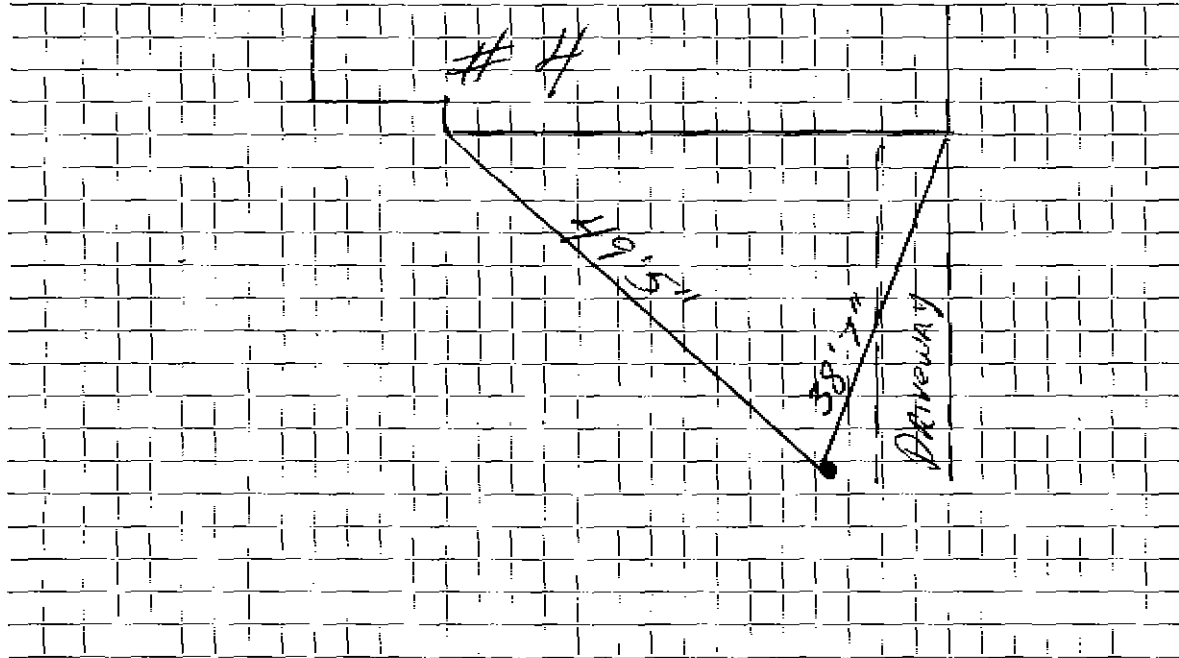

Connection made in Street. Work completed

Remarks:

.....

.....