

WATER SERVICE RECORD

#3244
#5865

Name James M. Casey

Service No.

53

Address 5 Great Rock Road

Location

~~Repair/Replacement~~ New Service

Com. 5-3-54


Date	Material	Amount	Total	Date	Amount
3/30/54	Labor	6 65		3-26-54	Deposited 50 00
	10% overhead	67	7 32	5-3-54	Refunded 88
	33'-3/4" Copper tubing @.35		11 55		<u>NON CHARGE</u> 49 12
	1-3/4" Cx 1/2 I.W.H. Stop & waste		4 00	3/30/54	Labor 6 65
	1 hr Littlefield shovel		7 50	30' 3/4" Copper tubing @.35	10 50
	1 hr trucking		75	1-3/4" C Corp cock	4 33
	Patching 18 x 3		18 00	1-3/4" Cx3/4" C.curb cock	4 67
			49 12	1- Box & mod	3 90
				1- 1/2 Offset tail piece	50
				1- 3/8 Straight tail piece	50
				1 hr Littlefield shovel	7 50
				1 hr trucking	75
					<u>39 80</u>

DATE _____

TOWN OF LEXINGTON — BOARD OF PUBLIC WORKS

WATER DIVISION

Sketch of Service Here

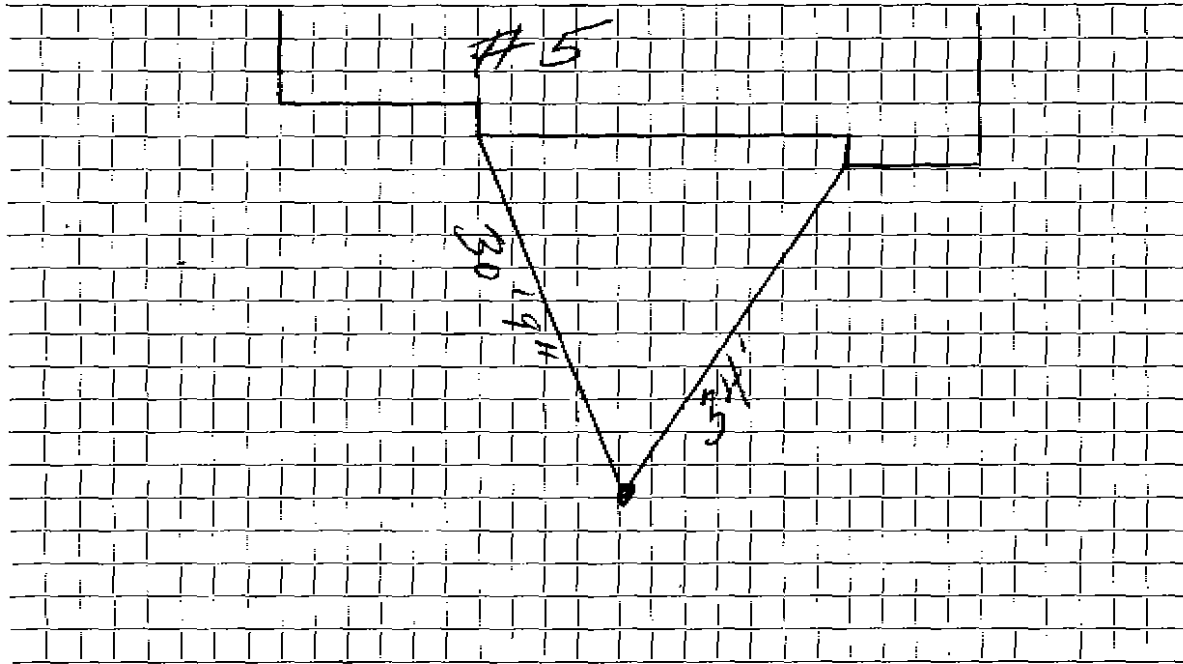

Connection made in Street. Work completed

Remarks:

.....

.....