

WATER SERVICE RECORD

Name Bernard C. Maloney

Service No. 313 (1954)

Address 7 Great Rock Rd.

3438

Location

~~Repair~~ ~~Rehook~~ New Service

Comm. 1-31-55


Date	Material	Amount	Total	Date	Amount
1/4/55	Labor	1 85		12-23-54	Deposited 40 00
	10% overhead	19	2 04	1-31-55	Refunded (29
	22' - 3/4" copper tubing @ .35		7 70		<u>NON CHARGE</u> 39 71
	1 - 3/4" C x 1/2 I.W.H. stop & waste		4 00	1/3/55	Labor 10 19
	1 - 3/4" C union		1 72		95' - 3/4" copper tubing @ .35 33 25
	1 hr. Littlefield shovel		7 50		1 - 3/4" C. corp-cock 4 33
	1 hr. trucking		75		1 - 3/4" C. curb-cock 4 67
	patching 16x3		16 00		1 - 3/4" C. union 1 72
			39 71		1 box and rod 3 90
	PART OF TRENCH DUG BY OWNER				1 - 1/2 offset tail piece 50
	PIPE SUPPLIED AND LAID BY OWNER				1 - 1/2 straight tail piece 50
					4 2/3 hrs. Littlefield shovel @ 7.50-35 00
					1 hr. trucking 75
					<u>94 81</u>

DATE _____

TOWN OF LEXINGTON — BOARD OF PUBLIC WORKS

WATER DIVISION

Sketch of Service Here

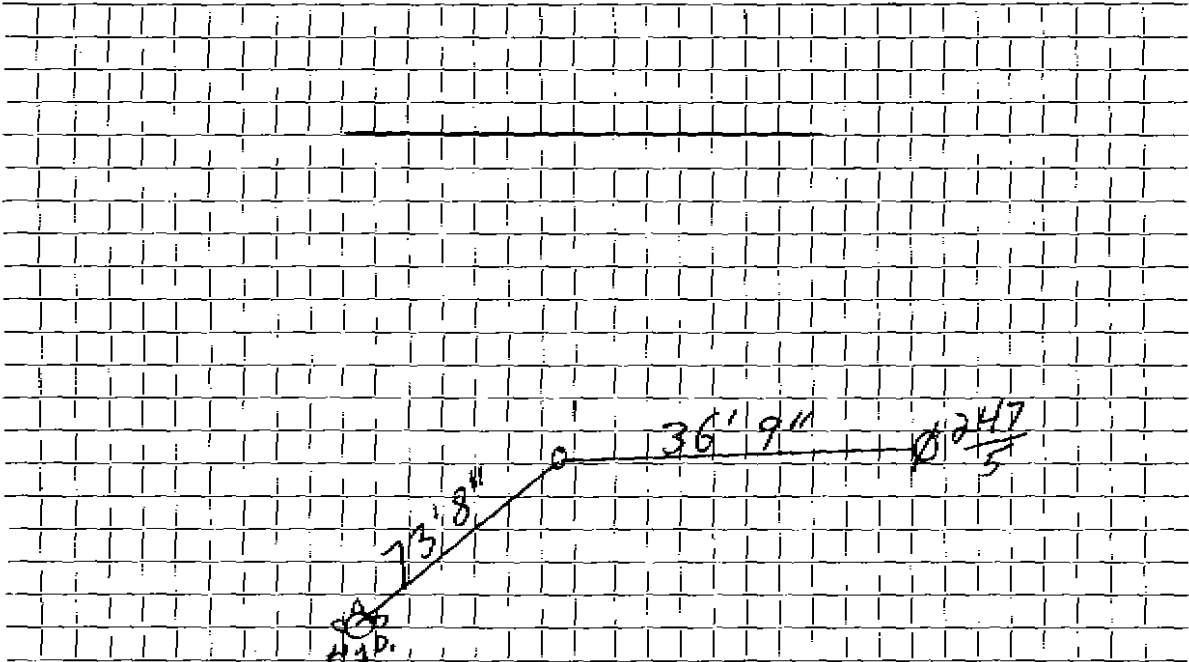

Connection made in Street. Work completed

Remarks:
.....
.....