


DATE 2-26-2002

TOWN OF LEXINGTON — BOARD OF PUBLIC WORKS
WATER DIVISION

Sketch of Service Here

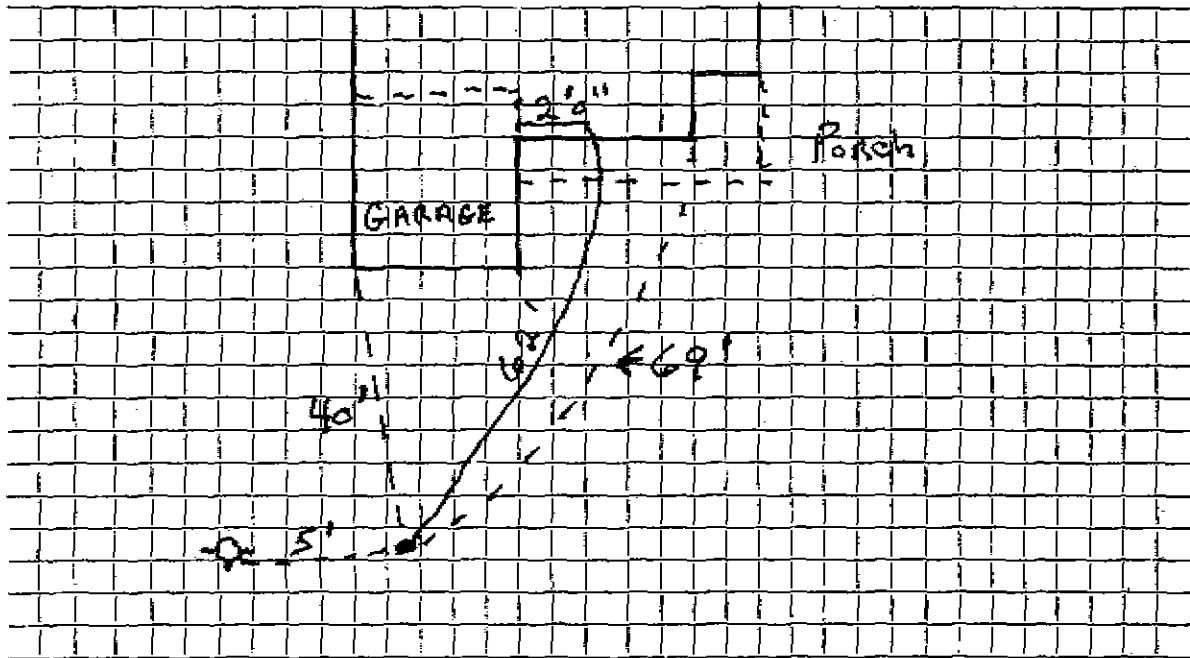

Connection made in GREAT ROCK Rd Street. Work completed

Remarks: J. M. McLAUGHLIN