

WATER SERVICE RECORD

Name Bernard C. Maloney

Service No. 314 (1954)

Address 9 Great Rock Road

Location

~~Repair - Renewal~~ - New Service


Com 1-31-55

Date	Material	Amount	Total	Date	Amount
1/4/55	Labor	1 85		12-23-54	Deposited 40 00
	10% overhead	19	2 04	1-31-55	Refunded 2 74
	15' - 3/4" copper tubing @ .35		5 25		NON CHARGE 37 26
	1 - 3/4" C x 3/4" I.W.H. stop & waste		4 00	1/3/55	Labor 5 09
	1 - 3/4" C. union		1 72	1/4/55	" 1 83
	1 hr. Littlefield shovel		7 50	1/5/55	" 8 10
	1 hr. trucking		75	55' - 3/4" copper tubing @ .35	19 25
	patching 16x3		16 00	1 - 3/4" C. corp-cock	4 33
			37 26	1 - 3/4" C. curb-cock	4 67
	PIPE SUPPLIED AND LAID BY OWNER:			1 box and rod	3 90
	PART OF TRENCH DUG BY OWNER:			1 1/2" straight tail pc.	30
				1 - 2" offset tail piece	50
				2 1/3 hrs. Littlefield shovel @ 7.50	17 50
				1 hr. trucking	75
					66 42

DATE _____

TOWN OF LEXINGTON — BOARD OF PUBLIC WORKS
WATER DIVISION

Sketch of Service Here

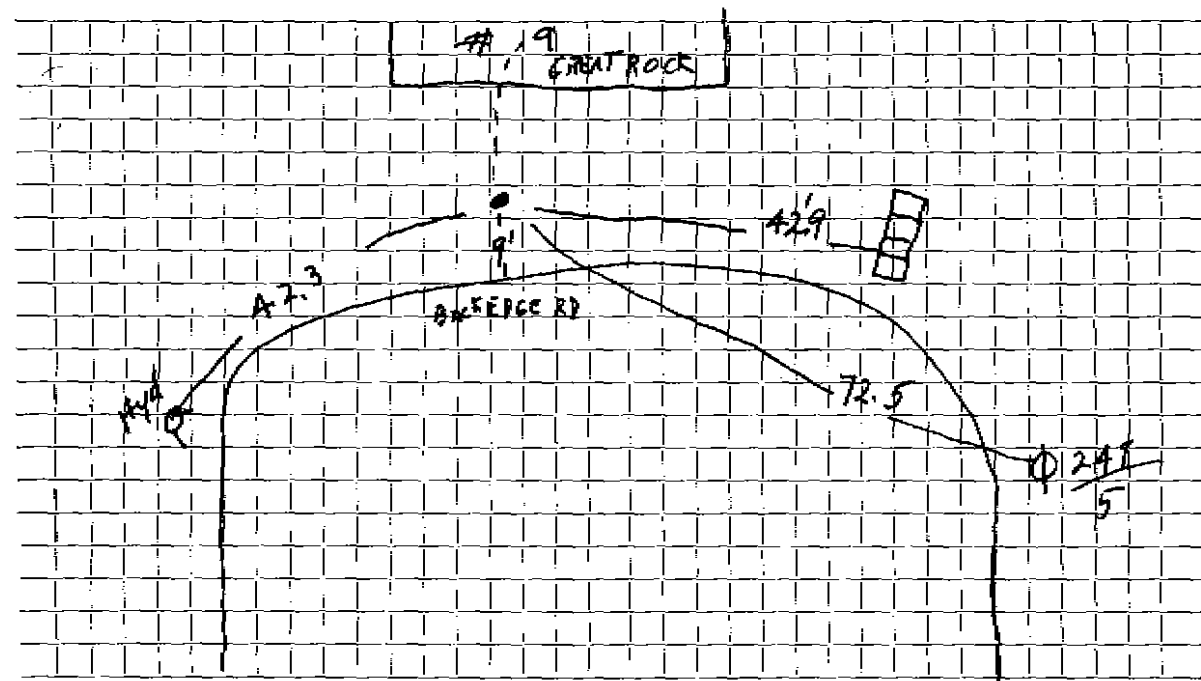

Connection made in Street. Work completed

Remarks:
.....
.....