

## WATER SERVICE RECORD

Name Gerald Baghasian

Service No. 1

Address 10 Green Lane

Location

~~Repairs at New Service~~ - New Service


Comm 11-17-58

Date	Material	Amount	Total	Date	Amount
5/16/58	Labor	35.42		4-8-58	Deposit 100.00
	10% Overhead	3.54	38.96	11-17-58	Refund 21.55
	45' 3/4" Copper Tubing @ 37		16.65		<del>21.55</del>
	1 3.4 x C x 1/2 I. W. H. Stop & Waste		5.84		78.45
	2 1/2 Hour Town Shovel @ 6.50		16.25	5/15/58	Labor 7.86
	1 Hour Trucking @ 75		75	10'	3/4" Copper Tubing @ 3.70
			78.45	1 3/4" C Corp Cock	4.64
				1 3/4" C Curb Cock	6.03
				1 Box & Rod	5.00
				1 1/2 Straight Tail Piece	50
				1 1/2 Offset Tail Piece	50
				1/2 Hour Town Shovel @ 6.50	3.25
				1 Hour Trucking @ 75	75
					32.23

DATE \_\_\_\_\_

**TOWN OF LEXINGTON — BOARD OF PUBLIC WORKS**  
**WATER DIVISION**

Sketch of Service Here

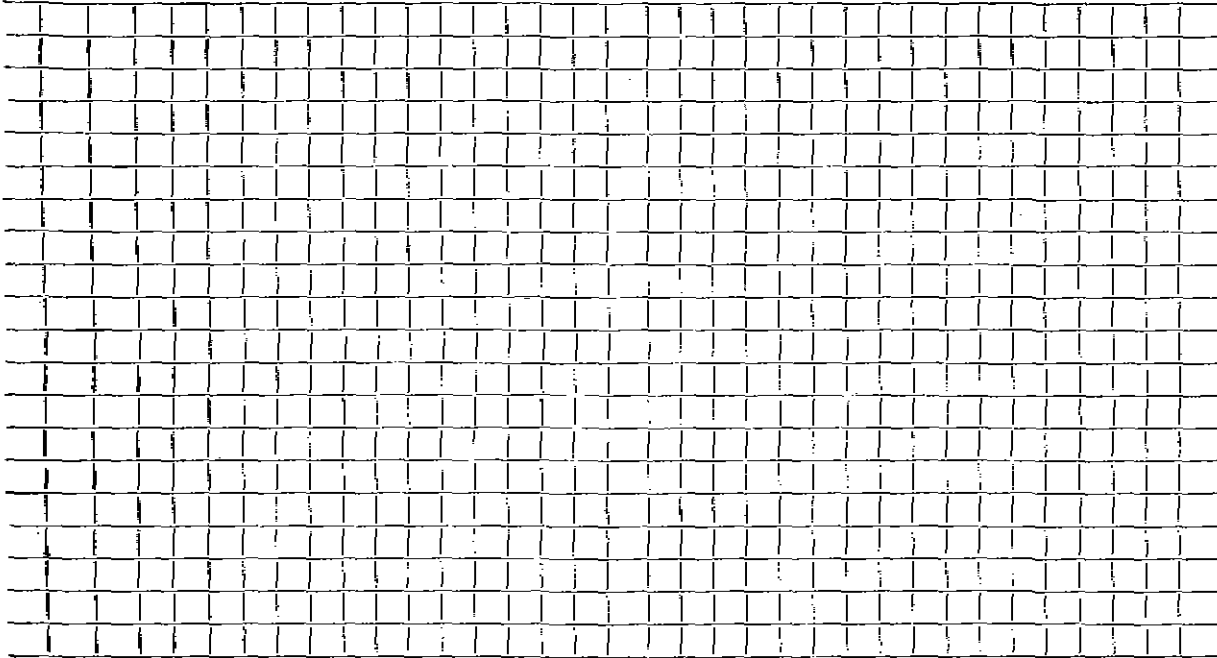

Connection made in ..... Street. Work completed .....

Remarks: .....  
.....  
.....