

WATER SERVICE RECORD

Name Anthony Mazza

Service No. 140

Address 12 Green Lane

Location

Repair ~~Renewal~~ — New Service

Amn 11-17-58


Date	Material	Amount	Total	Date	Amount
7/26/58	Labor	23 73		7-21-58	Deposit 100 00
	10% overhead	2 37		11-17-58	Retard 29 98
		31 10	31 10		70 02
	42' 3/4" copper tubing @ .37	15 54			
	1 3/4" Cx 1/2 I.W.H. Stop & Waste	5 84			NON CHARGE
	1 2/3 Hrs. town shovel @ 6.50	10 79			18' 3/4" copper tubing @ .37 6 66
	1 hr. trucking @ .75	75			1 3/4 c. corp cock 4 64
	1 hr. Rogers trailer @ 3.00	3 00			1 box & rod 5 00
	1 hr. trucking @ 3.00	3 00			1 3/4" G curb cock 6 03
			70 02		1/3 hr. town shovel 6.50 2 21
					1 1/2 straight tail pc. 50
					1 1/2 offset tail piece 50
					52 68

TOWN OF LEXINGTON — BOARD OF PUBLIC WORKS

WATER DIVISION

DATE _____

Sketch of Service Here

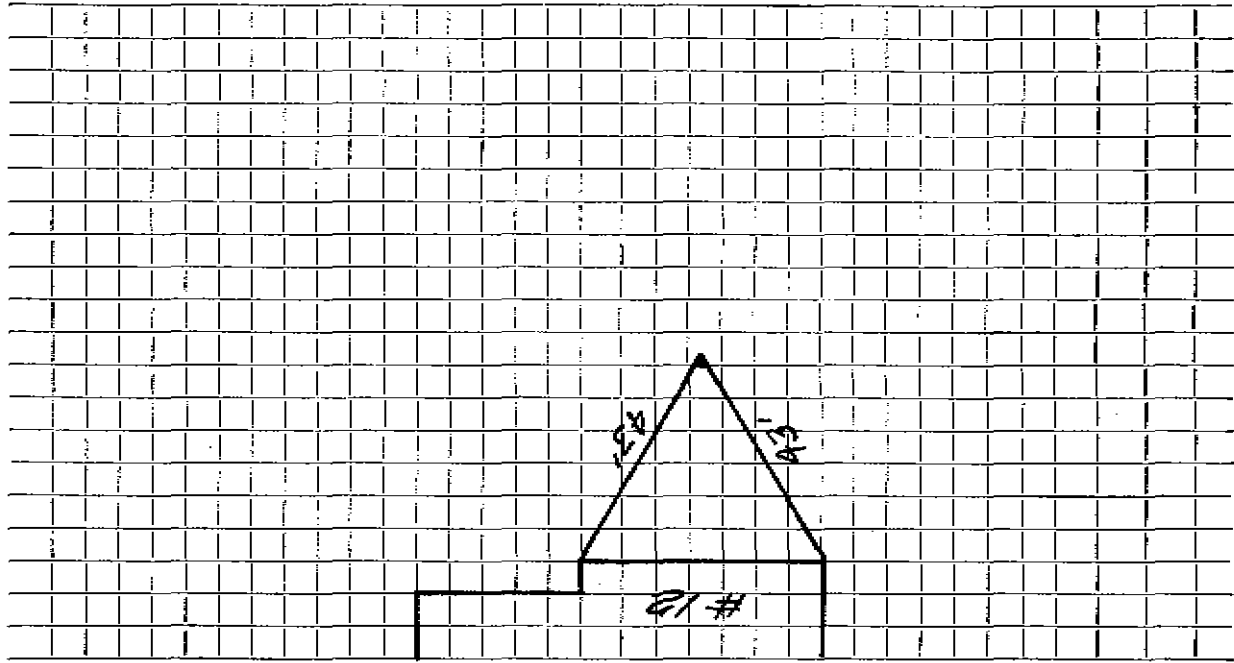

Connection made in _____

Street _____

Work completed _____

Remarks: _____

