

WATER SERVICE RECORD

Service No. 77

Name Anthony DePietro

Address 14 Green Lane

Location

~~Repair - Renewal~~ - New Service

*Com. 6-1-54*


Date	Material	Amount	Total	Date	Amount
5/19/54	Labor	6 90		4-13-54 Deposited	75 00
	10% Overhead	69	7 59	6-1-54 Refunded	(2 71)
	57' 3/4" Copper tubing @ .35	19 95			<u>NON CHARGE</u>
	1 - 3/4" Cx 1 I.W.H. stop & waste	4 00		5/19/54 Labor	16 10
	2 hrs. Ltfld. Shovel @ 7.50	15 00		65' 3/4" Copper tubing @ .35	22 75
	1 hr. trucking	75		1 - 3/4" C. Corp-cock	4 33
	Patching 25x3	25 00		1 - 3/4" Cx 3/4" C. curb-cock	4 67
6-19-78	10 3/4" Copper		72 29	1 Box & Rod	3 90
	1 3/4" C. - 3 Part Union			1 - 1/2 offset tail piece	50
	Installed by Town - W.O. #6394			1 - 1/2 straight tail piece	50
				3 hrs. Ltfld. Shovel @ 7.50	22 50
				1 hr. trucking	75
					<u>76 00</u>

DATE \_\_\_\_\_

TOWN OF LEXINGTON — BOARD OF PUBLIC WORKS

WATER DIVISION

Sketch of Service Here

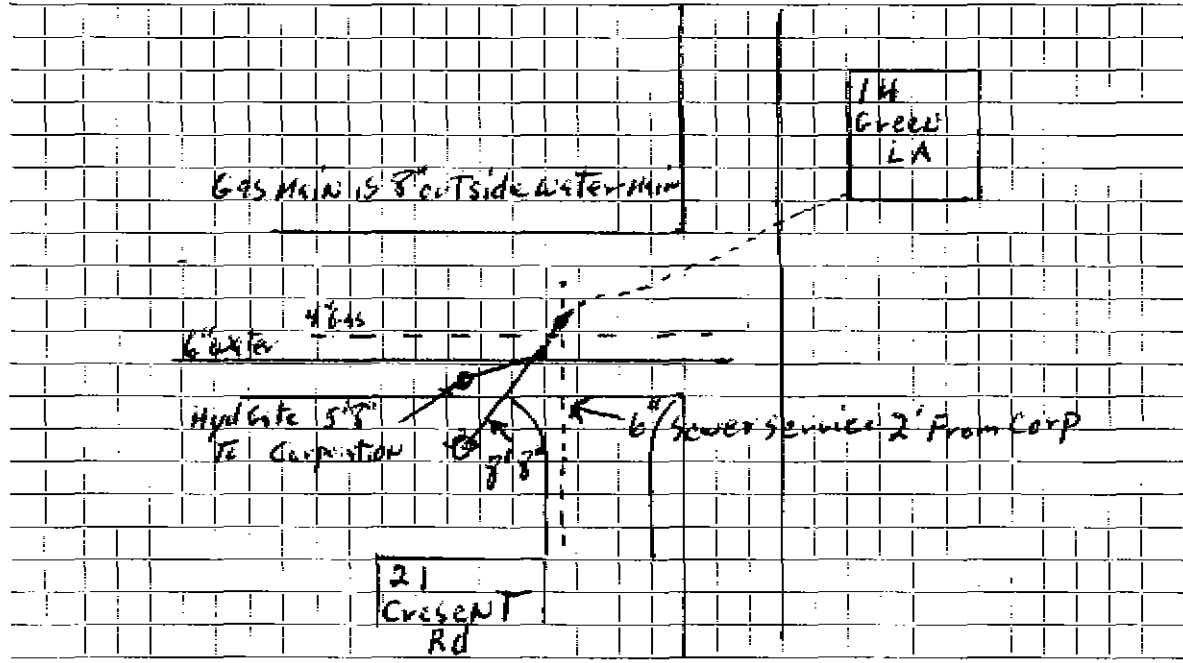

Connection made in ..... Street. Work completed .....

Remarks: .....  
.....  
.....