


DATE _____

TOWN OF LEXINGTON — BOARD OF PUBLIC WORKS

WATER DIVISION

Sketch of Service Here

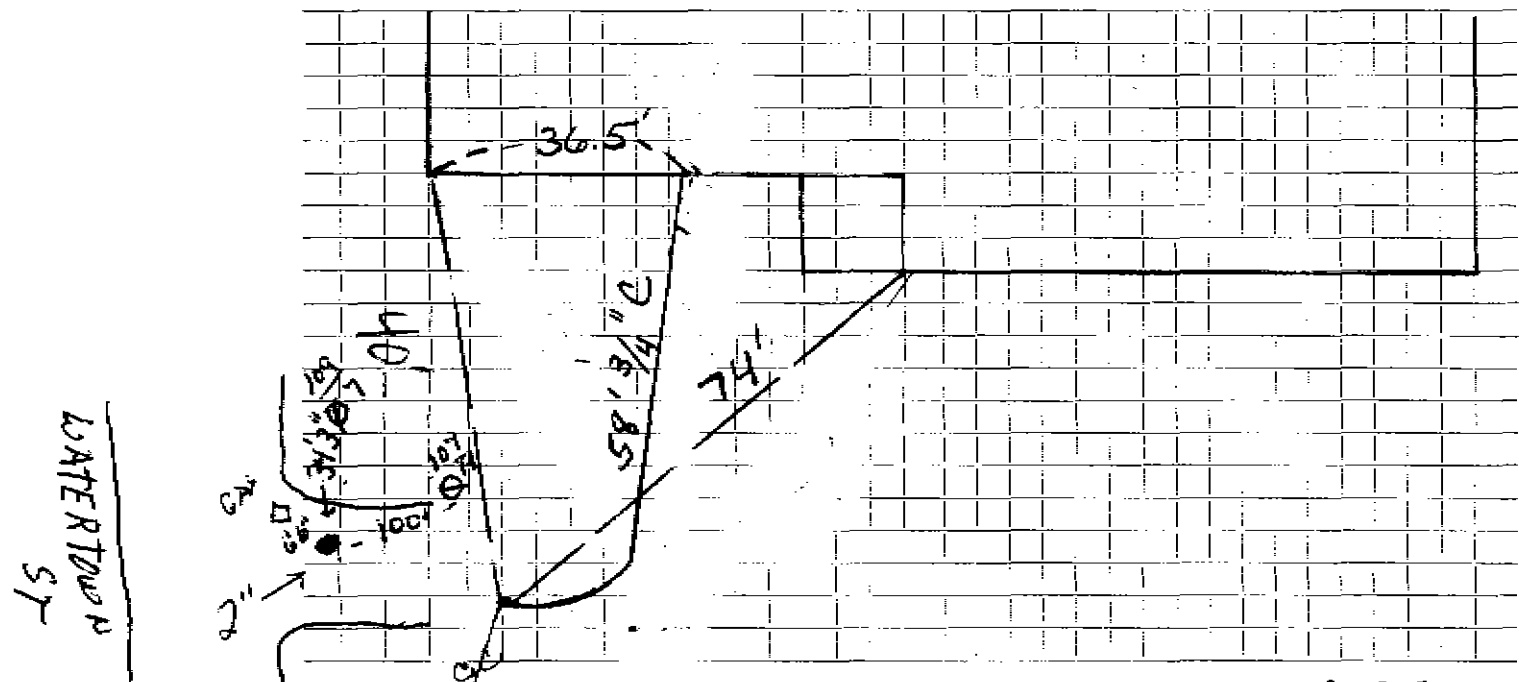

Connection made in .. GREEN LANE .. Street. Work completed .. JULY 25, 1976 ..

Remarks: 9' pd. off 2" line. 2" line feed - 27 Water Tower St. & 17 Green Ln.