

## WATER SERVICE RECORD

Name **Trebino Construction**Service No. **36**Address **4 Green Lane**Location **Lot 19**~~Repair~~ **New Service W.O. #7935***Comm 8-26-63*


Date	Material	Amount	Total	Date	Amount	
5/16/63	Labor	4 73		5-16-63	Deposit	50 00
	10% O.H.	47	5 20	8-26-63	* Refund	22 25
	39' 3/4" Copper Tubing @ .42		16 38			29 75
	1 3/4" C x 1/2" I.W.H. Stop & Waste		6 17			
			27 75		Curb to Main	
				5/16/63	Labor	7 88
					28' 3/4" Copper Tubing @ .42	11 76
					1 3/4" C Corp Cock	4 91
					1 3/4" C Curb Cock	6 28
					1 Bow & Rod	4 90
					1 1/2" Straight Tailpiece	50
					1 1/2" Offset Tailpiece	50
						<u>36 73</u>
					* Applied to SMC #45	

TOWN OF LEXINGTON — BOARD OF PUBLIC WORKS

WATER DIVISION

DATE \_\_\_\_\_

Sketch of Service Here

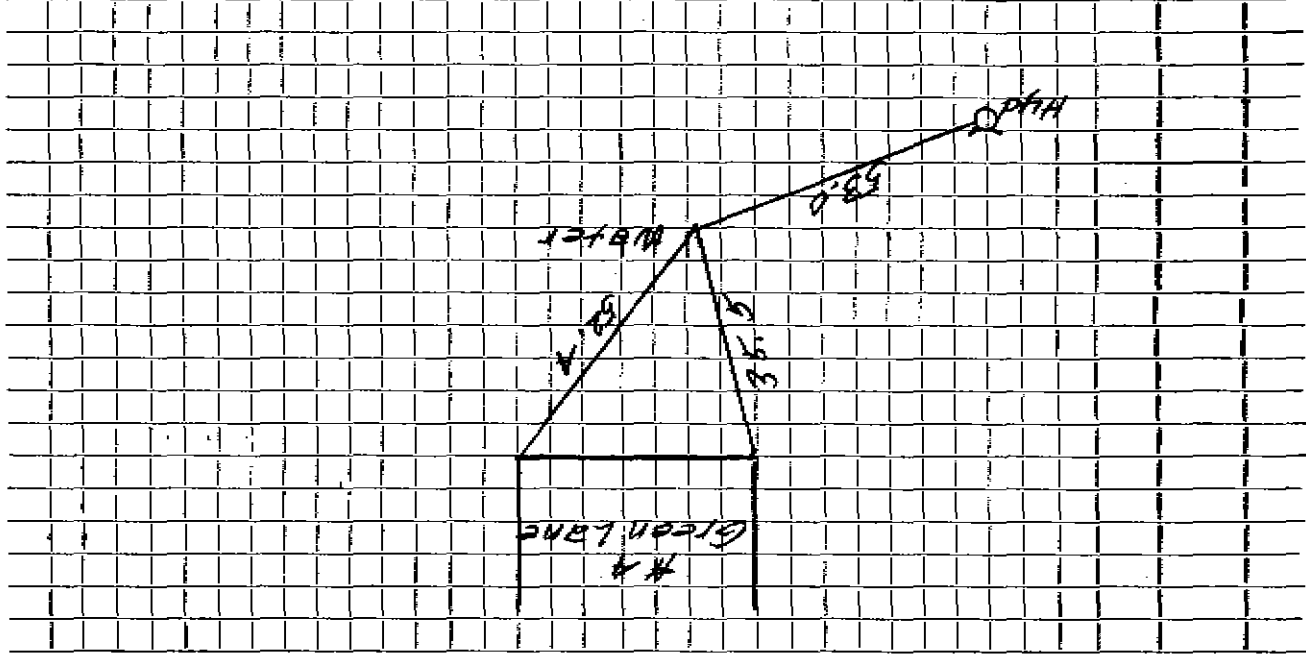

Connection made in \_\_\_\_\_

Street \_\_\_\_\_

Work completed \_\_\_\_\_

Remarks: \_\_\_\_\_