

WATER SERVICE RECORD

Name Donald Cruwys

Service No. 19

Address 5 Green Lane

Location

~~Repair~~ ~~Renewal~~ ~~New Service~~ Sibley #1115 W.O.#6688

AUG 5 1968


| Date | Material | Amount | Total | Date | Amount |
|---------|---------------------------|--------|--------|---------|--------|
| 7-17-68 | 39' 3/4" Copper tubing | | | 5-10-68 | 240 00 |
| 6/11/68 | Labor | 48 32 | | 8-5-68 | 99 61 |
| 6/17/68 | Labor | 15 08 | 63 40 | | 140 39 |
| | 10% O.H. | | 6 34 | | |
| | 12' 3/4" copper pipe @.79 | | 9 48 | | |
| | 1 3/4" corporation | | 9 57 | | |
| | 1 3/4" curb cock | | 11 32 | | |
| | Box & Rod | | 5 10 | | |
| | 1/2 Ton cold patch @ 5.50 | | 1 38 | | |
| | 1 Ton hot top @ 5.80 | | 5 80 | | |
| | 3 Hrs. trucking @ 3.00 | | 9 00 | | |
| | 2 Hrs. shovel @ 6.50 | | 13 00 | | |
| | 1/2 Hr. compressor @ 5.00 | | 2 50 | | |
| | 1/2 Hr. roller @ 3.00 | | 1 50 | | |
| | trailer | | 2 00 | | |
| | TOTAL COST | | 140 39 | | |

DATE _____

TOWN OF LEXINGTON — BOARD OF PUBLIC WORKS

WATER DIVISION

Sketch of Service Here

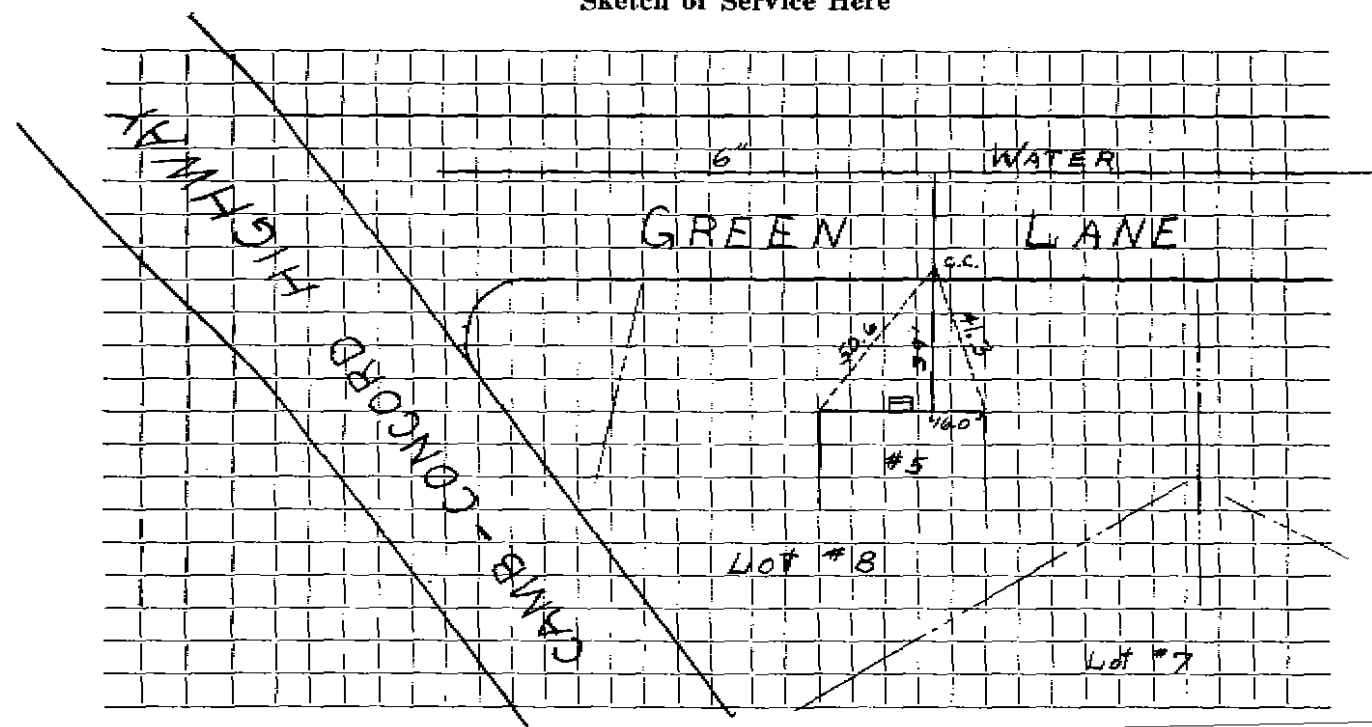

Connection made in Street. Work completed

Remarks:
.....
.....