

WATER SERVICE RECORD

Name Michael Graziano

Service No. 63

Address 6 Green Lane

Location

~~Repair-Renewal~~ New Service

Comm 7-5-60


Date	Material	Amount	Total	Date	Amount	
5-11-60	Labor	32.26		5-9-60	Deposit	100.00
	10 % O.H.	3.23	35.49	7-5-60	Retard	11.70
42'	3/4" Copper tubing @ .42		17.64			88.30
1	3/4" Cx 1/2 I.W.H. Stop & Waste		6.17			
4	Hrs. Pippin Shovel @ .65		26.00		NON CHARGE	
1	Hr. Trucking @ 3.00		3.00		Labor	18.74
			88.30	24'	3/4" Copper tubing	10.08
				1	3/4" C Corp Cock	4.91
				1	3/4" C Curb Cock	6.28
				1	Box & Rod	5.00
				1	1/2 Straight tailpiece	5.00
				1	3/8 Offset tailpiece	5.00
						45.74

DATE _____

TOWN OF LEXINGTON — BOARD OF PUBLIC WORKS

WATER DIVISION

Sketch of Service Here

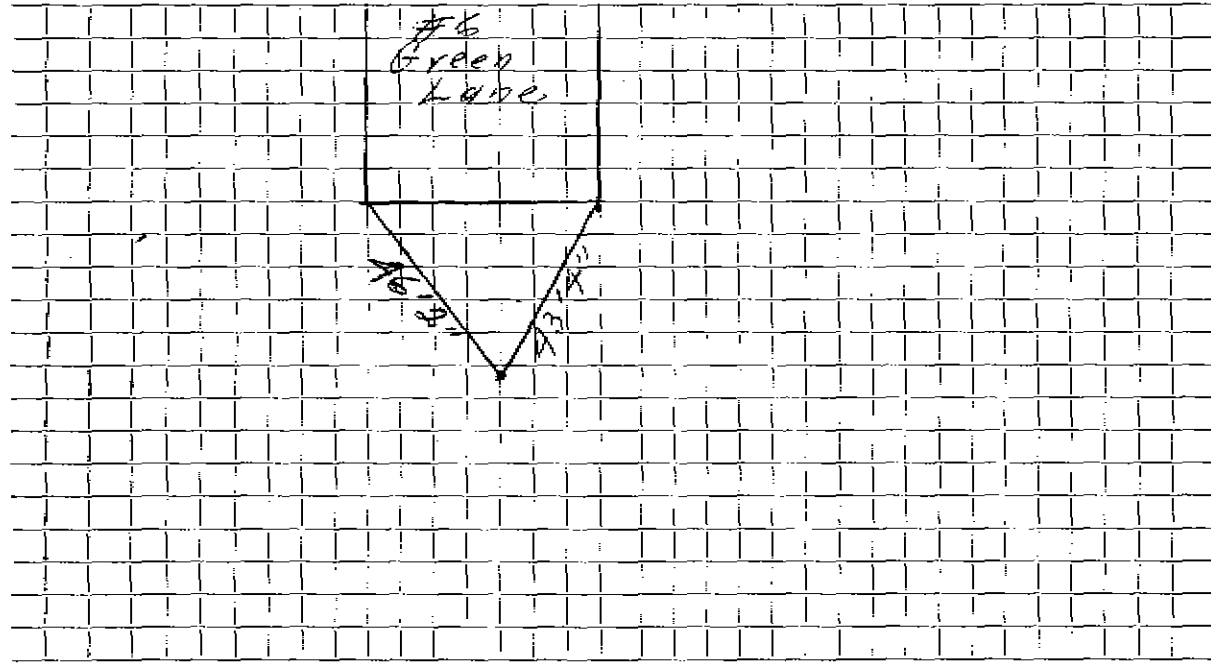

Connection made in Street. Work completed

Remarks:
.....
.....