

Name

#4464
Service No. 1099

Address 18 Greenwood St.

Location

18 Greenwood St.

Kind of Pipe

Size

Size of Main

Repair—Renewal—New Service

Location

Date

Material

Amount

Total

Date

Amount

Labor

DATE _____

TOWN OF LEXINGTON—BOARD OF PUBLIC WORKS

WATER DIVISION

The undersigned applies for a supply of water at No. _____ St. and hereby agrees to comply with the rules and regulations as now, or at any future time, established by the Board of Selectmen.

Am't. of Estimate \$ _____

Owner

P. Knox


Am't. Paid \$ _____

Address

18 Greenwood St

Builder _____

Sketch of Service Here

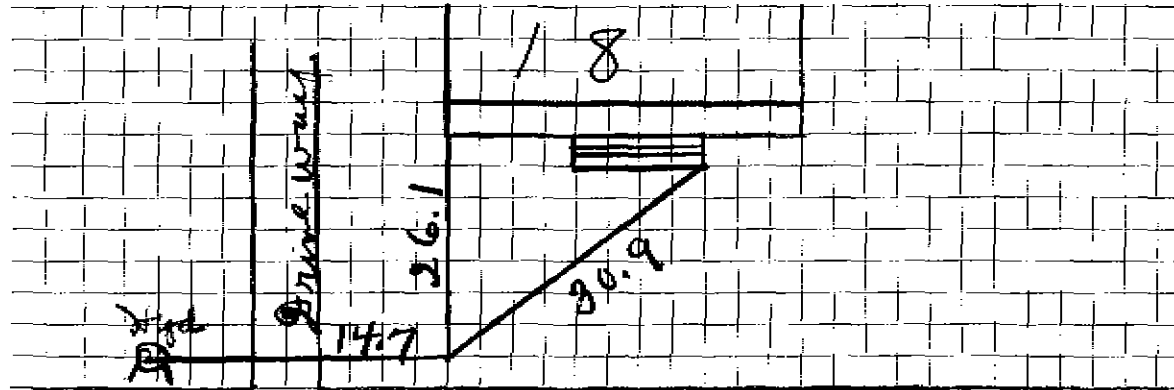

Connection made in _____

Greenwood St.

Work completed _____

19

Remarks: