

WATER SERVICE RECORD

Name Leeland Const. Co.

Service No. 41

Address 23 Greenwood St.

Location Lexington

Repair ~~Renewal~~ - New Service Com. 3/30/53


Date	Material	Amount	Total	Date	Amount
3/6/53	Labor	4 26		2-27-53	Deposited 50 -
	10% overhead	43	4 69	3-30-53	Refunded (11 60)
	44' -3/4" copper tubing@ .34		14 96		NON CHARGE (28 40)
	1 -3/4" C x 1/2 I.W.H.stop& waste		4 00	3/6/53	Labor 4 27
	2 hrs.Littlefield shovel @ 7.		14 00		16' -3/4" copper tubing@ .34 5 44
	1 hr. trucking		75		1 -3/4" C.corp-cock 4 33
			38 40		1 -3/4" C x 3/4" C.curb-cock 4 67
					1 box and rod 3 90
					1 -1/2" straight tail piece 50
					1 -1/2" offset tail piece 50
					1 hr. Littlefield shovel 7 00
					1 hr. trucking 75
					31 36

DATE _____

TOWN OF LEXINGTON — BOARD OF PUBLIC WORKS

WATER DIVISION

Sketch of Service Here

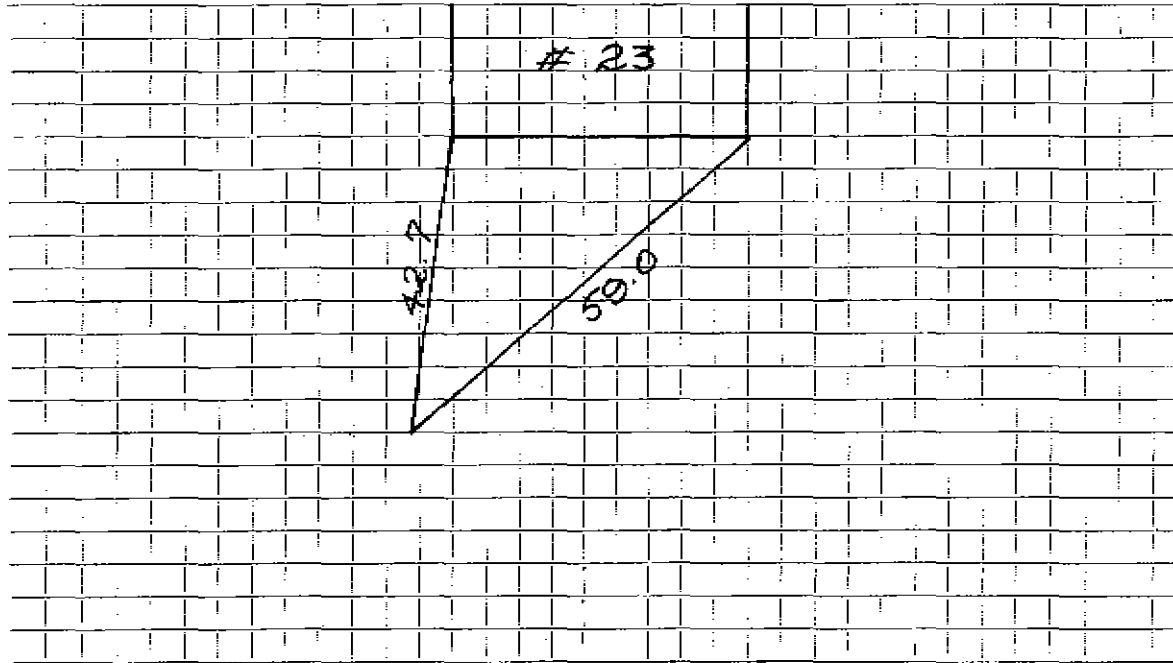

Connection made in Street. Work completed

Remarks:

.....

.....