

WATER SERVICE RECORD

Name _____ Service No. _____

Address 28 Greenwood Street

Location _____

Repair—Renewal—~~NEW SERVICE~~


Date	Material	Amount	Total	Date		Amount
					NON CHARGE	
				4-13-59	Labor	2 14
					15 3/4" Copper Tube@.3666	5 50
					1 3/4" C Curb Cock	6 03
					1 3/4" C Corp Cock	4 64
					1 Box & Rod	5 00
						23 31
				1959	Labor	4.28
					10 3/4" Copper tubing@3666	3.67
					1 3/4" Adapter	1.95
					1 3/4" Curb Cock	6.03
					1 1" L.L. Coupling	.54
					1 1" x 1/2" C.L.Nipple	.28
					1 1" Style 38 Repair Clamp	2.14
						42.20

DATE _____

TOWN OF LEXINGTON — BOARD OF PUBLIC WORKS

WATER DIVISION

Sketch of Service Here

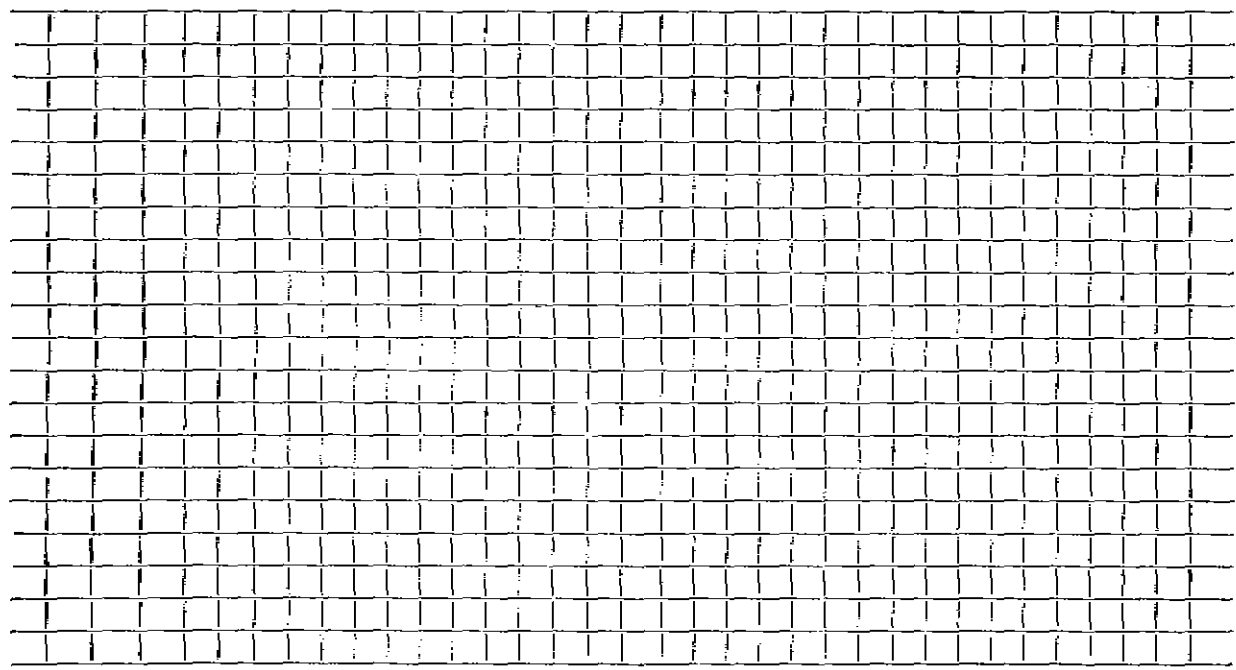

Connection made in Street. Work completed

Remarks:
.....
.....