

WATER SERVICE RECORD

H 2565

Name Leeland Const.

Service No. 10

Address 29 Greenwood St.

Location Lexington

~~Repair~~ ~~Renewal~~ ~~New Service~~ COM.2-16-53


Date	Material	Amount	Total	Date	Amount
1/20/53	Labor	1 63		1-16-53 Deposited	20 00
	10% overhead	16	1 79	2-16-53 Refunded	(1 54)
	30'-3/4" Copper Tubing @.34		10 20		18 46
	1-3/4" Cx 1/2 I.W.H. stop & waste		4 00	1/20/53 Labor	7 37
	1-3/4" C x 3/4" C. Union(3 Parts)		1 72	35'-3/4" Copper Tubing @.34	11 90
	1 Hr Trucking		75	1-3/4" C. Corp-cock	4 33
			18 46	1-3/4" Cx 3/4" C. Curb-cock	4 67
	TRENCH DUG BY OWNER			1- Box & rod	3 90
				1-1/2 straight tail piece	50
				1- 1/2 offset tail piece	50
				1 Hr Trucking	75
					33 92

DATE _____

TOWN OF LEXINGTON — BOARD OF PUBLIC WORKS

WATER DIVISION

Sketch of Service Here

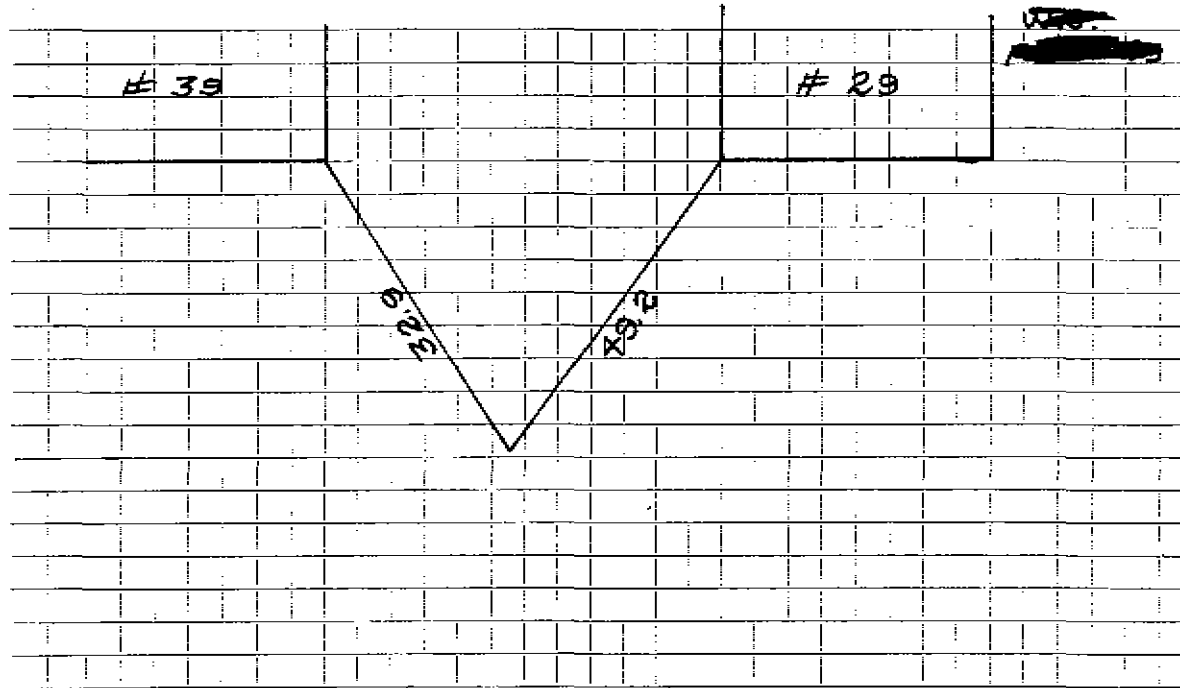

Connection made in Street. Work completed

Remarks:
.....
.....