

WATER SERVICE RECORD

Name Leeland Const.

Service No. 11

Address 30 Greenwood St.

Location Lexington

Repair ~~XXXXXX~~ New Service COM. 2-16-53


Date	Material	Amount	Total	Date	Amount	
1/20/53	Labor	1 63		1-16-53	<i>Deposited</i> <i>paid</i>	
	10% overhead	16	1 79	2-16-53		
	45' - 3/4" Copper Tubing @ .34	15 30				
	1-3/4" Cx 1/2 I.W.H. stop & waste	4 00			NON CHARGE	
	1 Hr. Trucking		75	1/20/53	Labor	7 37
	TRENCH DUG BY OWNER		21 84		15' - 3/4" Copper Tubing @ .34	5 10
					1-3/4" C. Corp-cock	4 33
					1-3/4" Cx 3/4" C. Curb-cock	4 67
					1- Box & Rod	3 90
					1- 1/2 offset tail piece	50
					1- 1/2 straight tail piece	50
					1 hr Trucking	75
						27 12

DATE \_\_\_\_\_

TOWN OF LEXINGTON - BOARD OF PUBLIC WORKS

**WATER DIVISION**

Sketch of Service Here

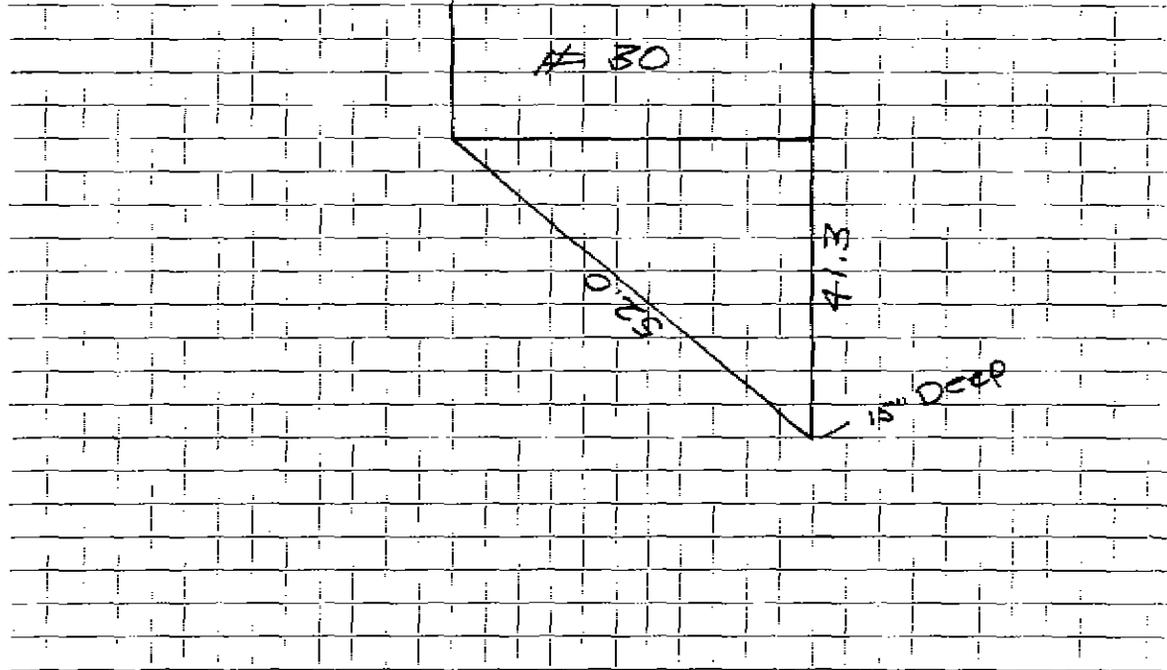

Connection made in ..... Street. Work completed .....

Remarks: .....

.....

.....