

WATER SERVICE RECORD

# 5462

Name Leeland Const.

Service No. 12

Address 32 Greenwood St.

Location Lexington

Repair ~~Renewal~~ - New Service COM. 2-16-53


Date	Material	Amount	Total	Date	Amount
1/16/53	Labor	1 63		1-16-53	Deposited 20 00
	10% overhead	16	1 79	2-16-53	Paid 14
	40'-3/4" Copper Tubing @.34		13 60		NON CHARGE 20 14
	1-3/4" Cx 1/2 I.W.H. stop & waste	4 00		1/16/53	Labor 4 51
	1 Hr Trucking		75	20'-3/4" Copper Tubing @.34	6 80
			20 14	1-3/4" C. Corp-cock	4 33
	<b>TRENCH DUG BY OWNER:</b>			1-3/4" C x 3/4" C. Curb-cock	4 67
				1-Box & Rod	3 90
				1-1/2 Straight tail piece	50
				1-1/2 offset tail piece	50
				1 Hr. Trucking	75
					25 96

DATE \_\_\_\_\_

TOWN OF LEXINGTON — BOARD OF PUBLIC WORKS

**WATER DIVISION**

Sketch of Service Here

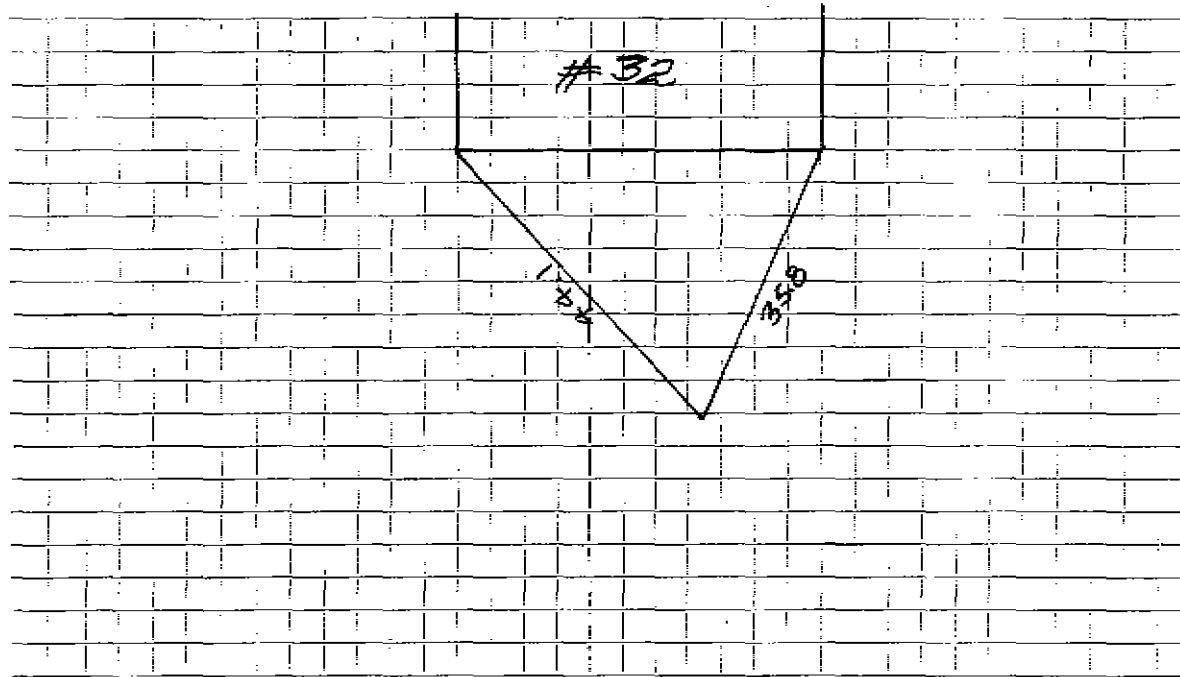

Connection made in ..... Street. Work completed .....

Remarks: .....

.....

.....